

ATTACHMENT E-11

**Lithologic and Well Construction Logs
for the E&R Ponds and SWMU Area
Compliance Monitoring Well System**

EMERGENCY AND RETENTION PONDS AREA

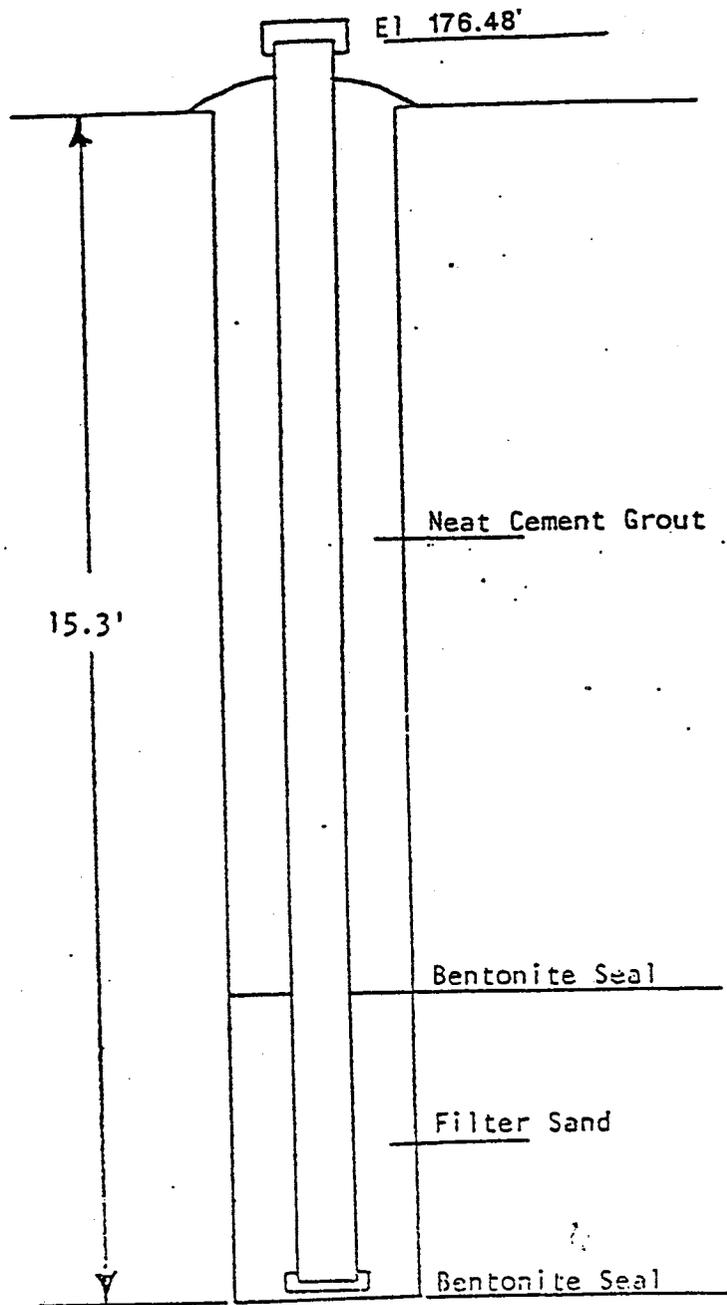


(not to scale)

WELL LOCATION DIAGRAM
Torrington Bearing Plant
Sylvania, Georgia



STB CONSULTANTS, LTD.
2625 ANNAPOLIS LANE, SUITE 200
MINNEAPOLIS, MINNESOTA 55411

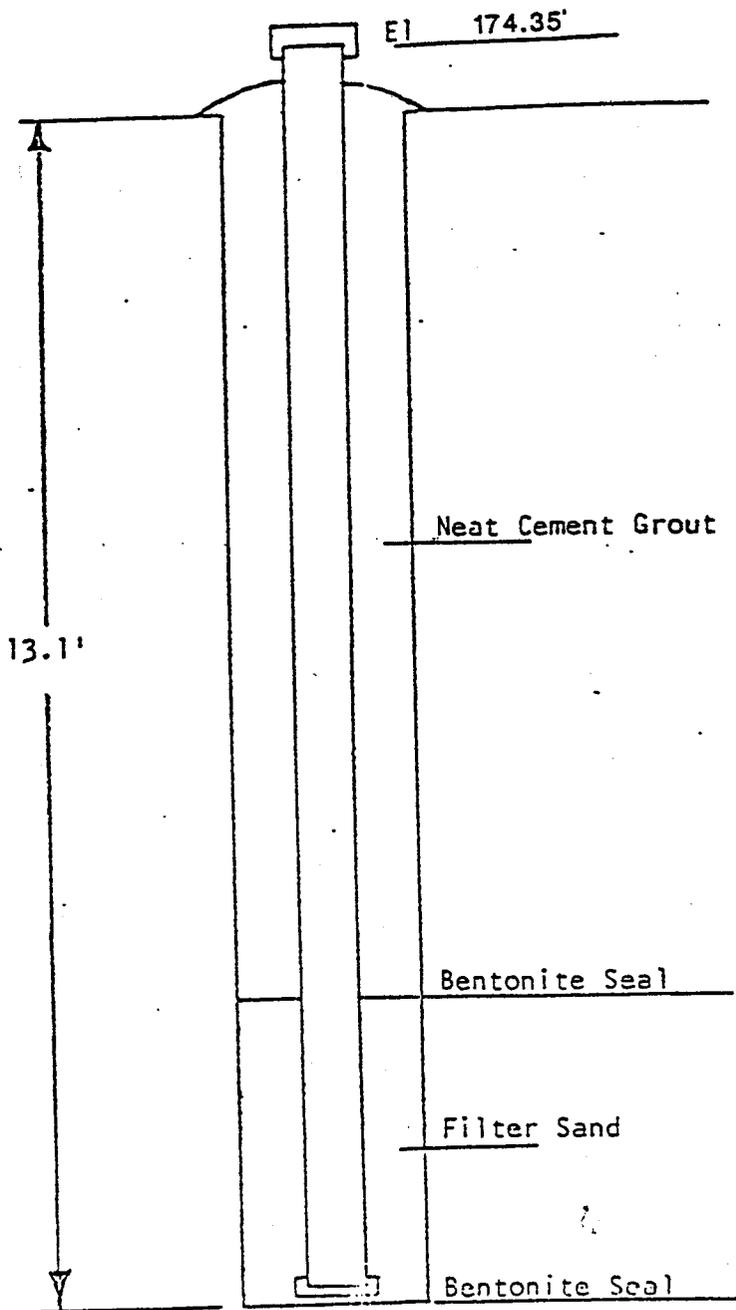


(not to scale)

WELL LOCATION DIAGRAM
Torrington Bearing Plant
Sylvania, Georgia

STJ CONSULTANTS, LTD.
2439 ANNAPOLIS LANE, SUITE 209
MINNEAPOLIS, MINNESOTA 55447

PROJECT: TORRINGTON CO.
 LOCATION: SVIVANTA, GEORGIA
 WELL NUMBER: W-3D
 DATE INSTALLED: April 21-27, 1988

ELEVATION: 175.00 FEET
 GROUND CASING PROTECTOR CASING
 ABOVE GROUND LEVEL ABOVE MEAN SEA LEVEL

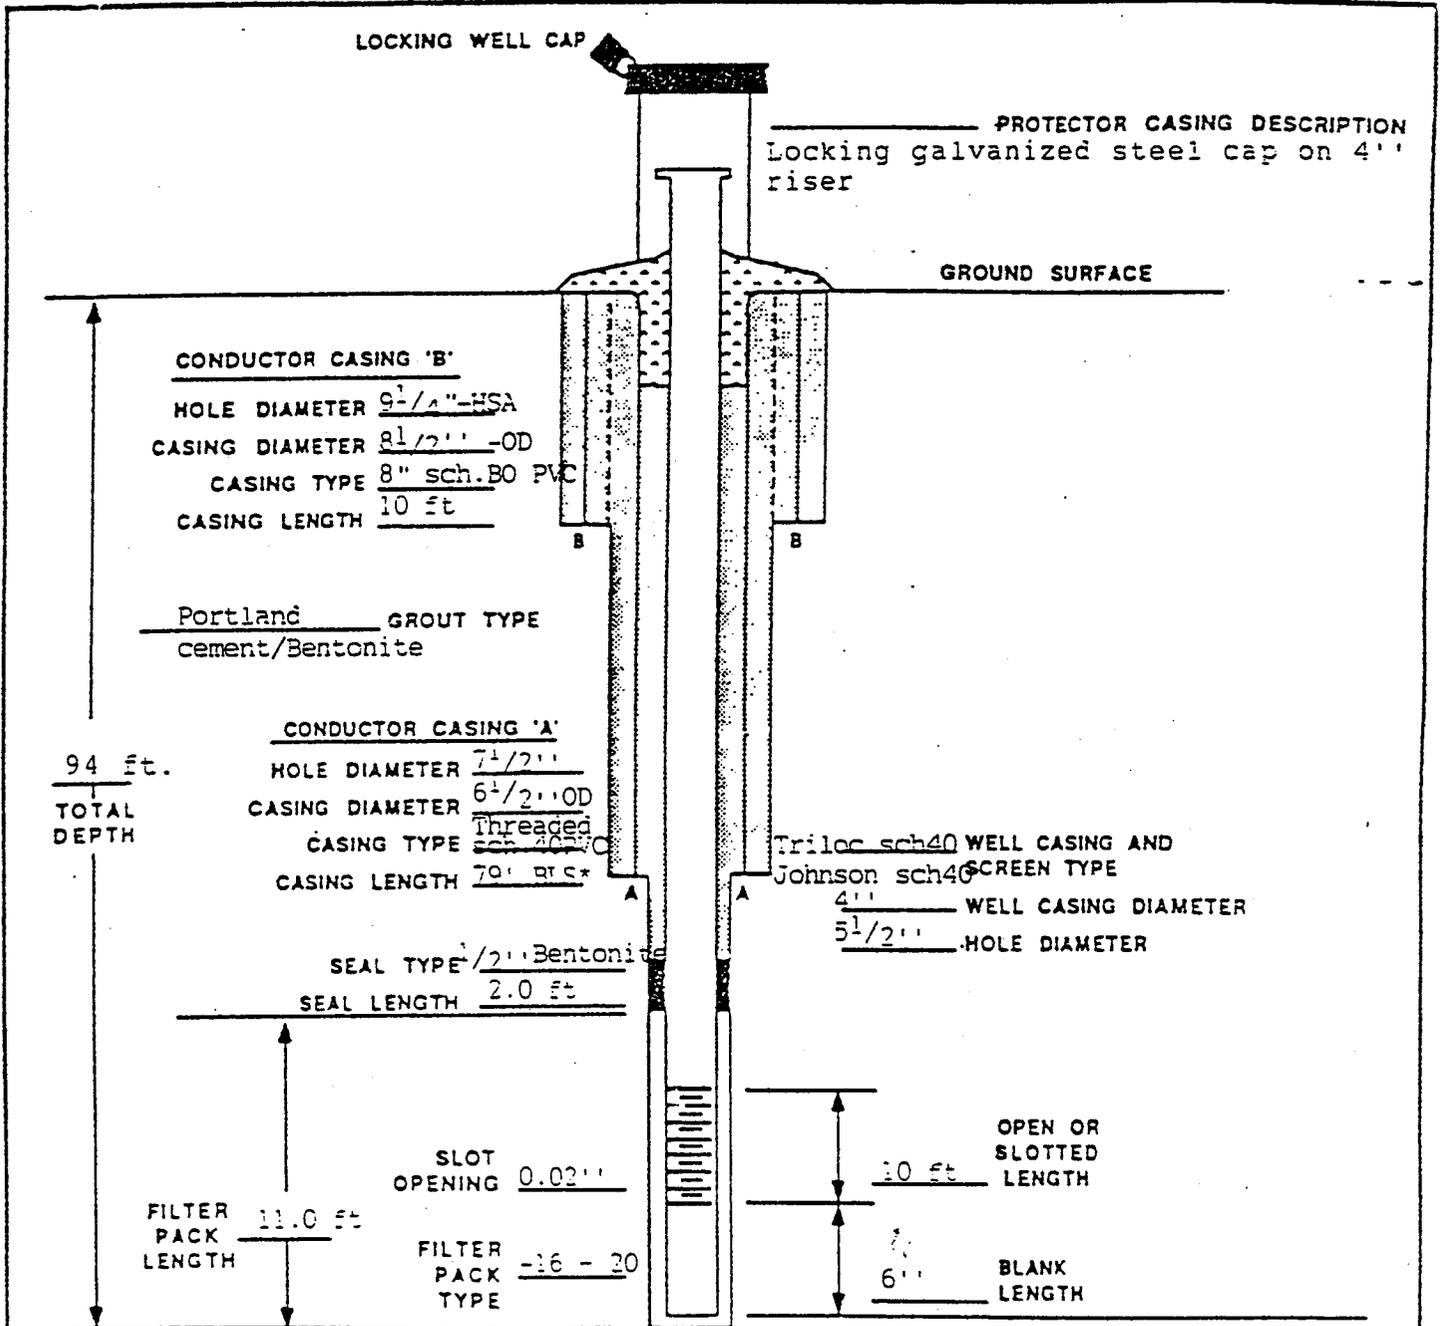


COMMENTS: 2 outer casings were set. The first using hollow stem augers and the second using mud rotary. A 4" well was set to total depth. The filter patch was tremied with 1/2" PVC pipe. Well was sealed with 1/2" bentonite pellets. Grout was tremied using the same tremie pipe for the sand. A locking well cover was installed at the top of the well. The well was developed using a submersible Brainard-Kilman hand pump.

*BLS = Below Land Surface


DRILLING LOG	COMPANY <i>Torrington</i>	INSTALLATION	SHEET 1 OF 1 SHEETS
LOCATION (Coordinates or Station)		SIZE AND TYPE OF BIT	
DRILLING AGENCY <i>Geothermics</i>		TOTAL NO. OF OVERBURDEN SAMPLES TAKEN	
THICKNESS OF OVERBURDEN		DATE HOLE	STARTED <i>1 June 85</i> COMPLETED <i>19 June 85</i>
DEPTH DRILLED INTO ROCK		ELEVATION TOP OF HOLE	
TOTAL DEPTH OF HOLE		ELEVATION GROUND WATER	
NAME OF DRILLER <i>Paul N. Clawson</i>		SIGNATURE OF INSPECTOR OR GEOLOGIST <i>David F. T. [Signature]</i>	

ELEVATION	DEPTH	LEGEND	CLASSIFICATION OF MATERIALS (Description)	SPT	BOX OR SAMPLE NO.	REMARKS (Drilling time, water loss, depth of weathering, etc., if significant)
-----------	-------	--------	--	-----	-------------------	---

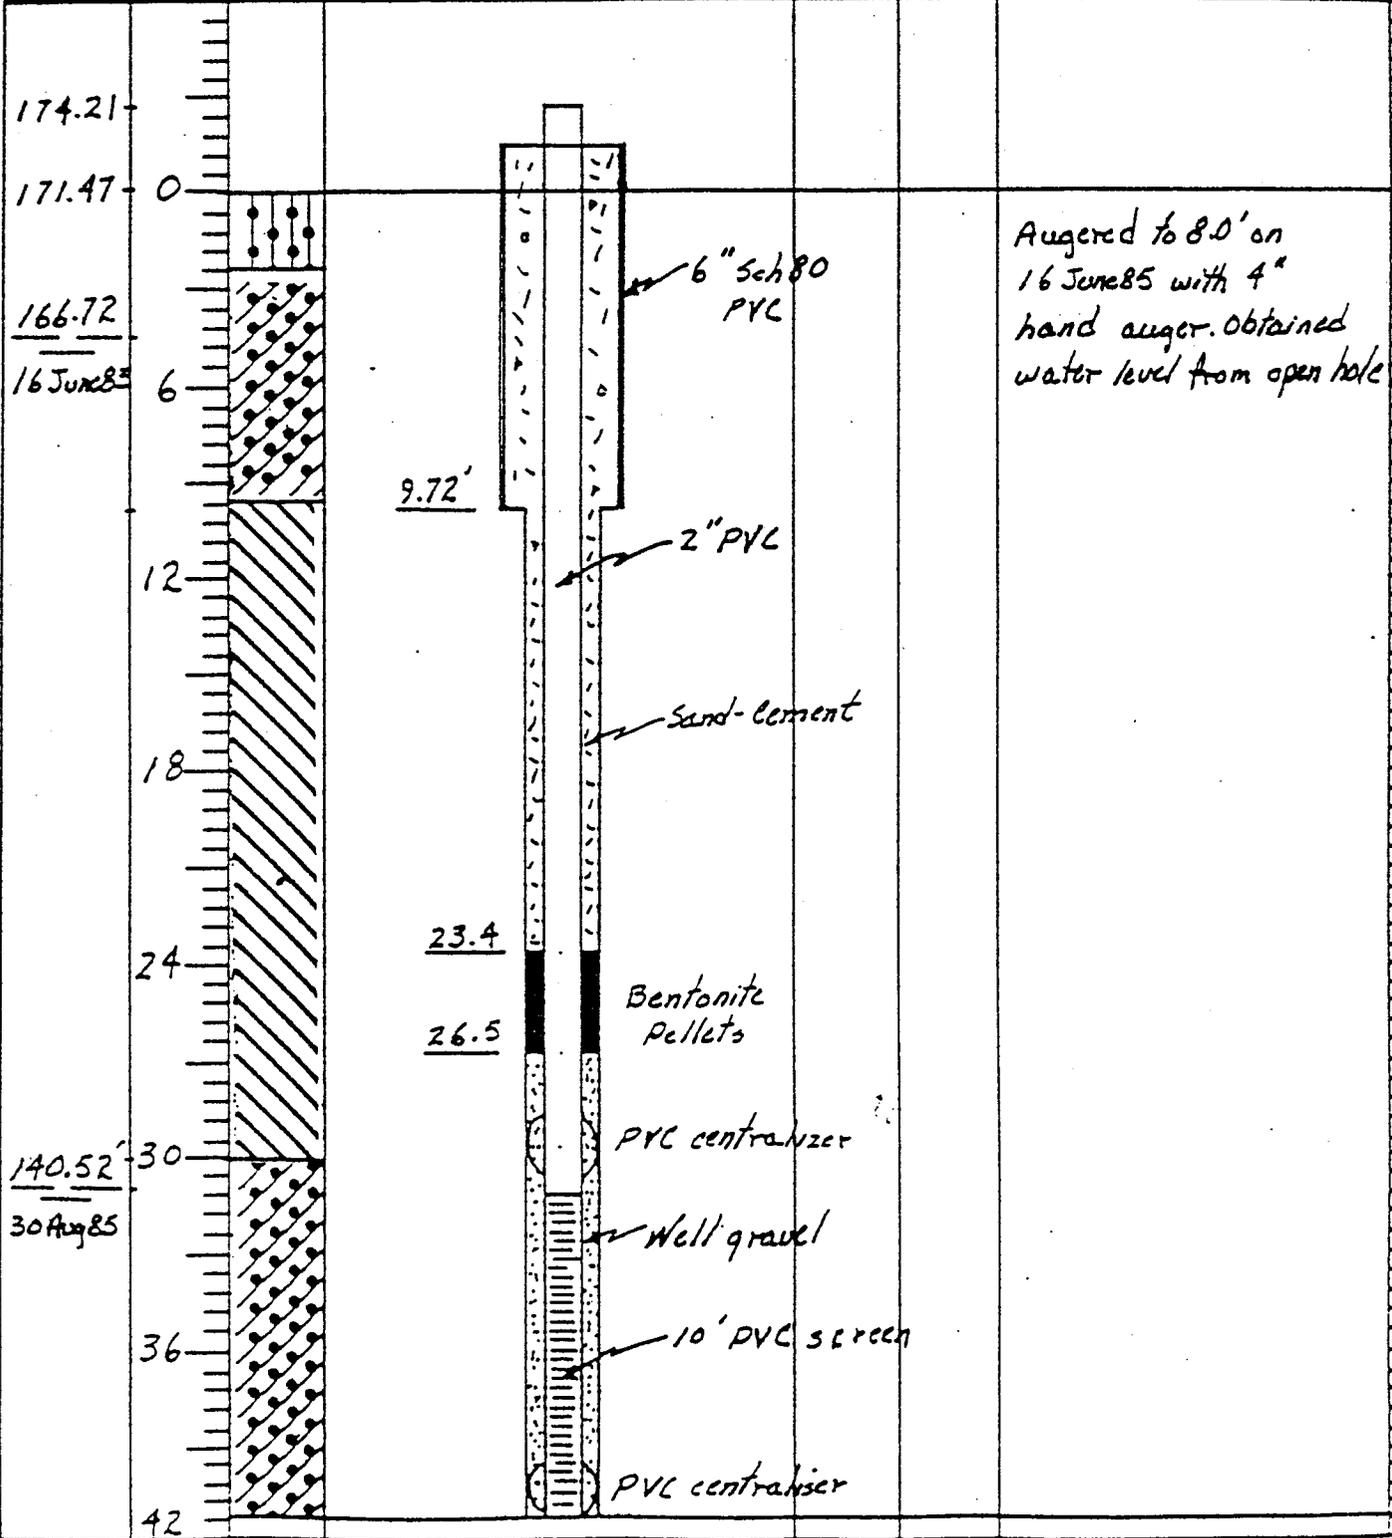


DRILLING LOG	COMPANY <i>Torrington</i>	INSTALLATION <i>Sylvania, Ga</i>	SHEET OF 1 SHEETS
LOCATION (Coordinates or Station)	SIZE AND TYPE OF BIT		
DRILLING AGENCY <i>Geothermics</i>	TOTAL NO. OF OVERBURDEN SAMPLES TAKEN		
THICKNESS OF OVERBURDEN	DATE HOLE	STARTED <i>15 June 85</i>	COMPLETED <i>18 June 85</i>
DEPTH DRILLED INTO ROCK	ELEVATION TOP OF HOLE		
TOTAL DEPTH OF HOLE	ELEVATION GROUND WATER		
NAME OF DRILLER <i>Paul N. Clawson</i>	SIGNATURE OF INSPECTOR OR GEOLOGIST <i>Paul F. Tolson, P.G.</i>		

ELEVATION	DEPTH	LEGEND	CLASSIFICATION OF MATERIALS (Description)	SPT	BOX OR SAMPLE NO.	REMARKS (Drilling time, water loss, depth of weathering, etc., if significant)
175.32						
172.17	0					Augered to 12.0' with hand auger "4". Obtained water level in this hole prior to using drill.
<u>165.07</u>	6					
<i>15 June 85</i>						
	12					
			11.7'			
	18					
	24					
			28.0			
	30					
<u>142.17</u>						
<i>30 Aug 85</i>						
			25.0			
	36					
	42					
	45					
			33.5			

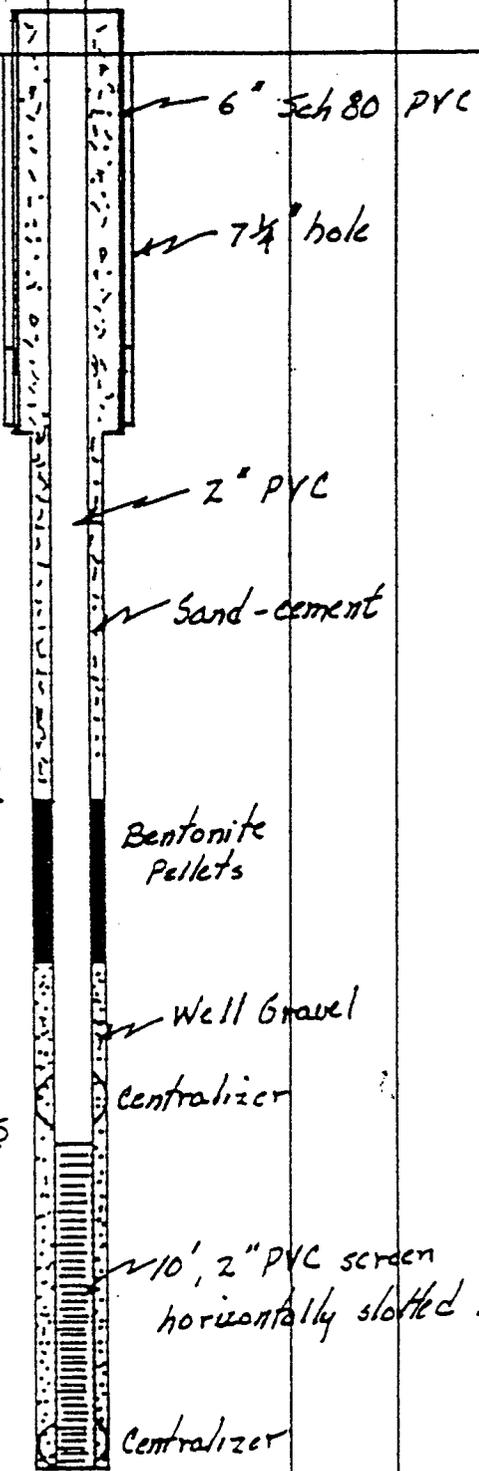


PROJECT: HORRINGTON
 LOCATION: Sulwama GA. W boundary
 WELL NUMBER: W-15. north corner ELEVATION: 150.32
 DATE INSTALLED: July 26-27, 1987 GROUND CASING PROTECTOR CASING
 ABOVE GROUND LEVEL ABOVE MEAN SEA LEVEL

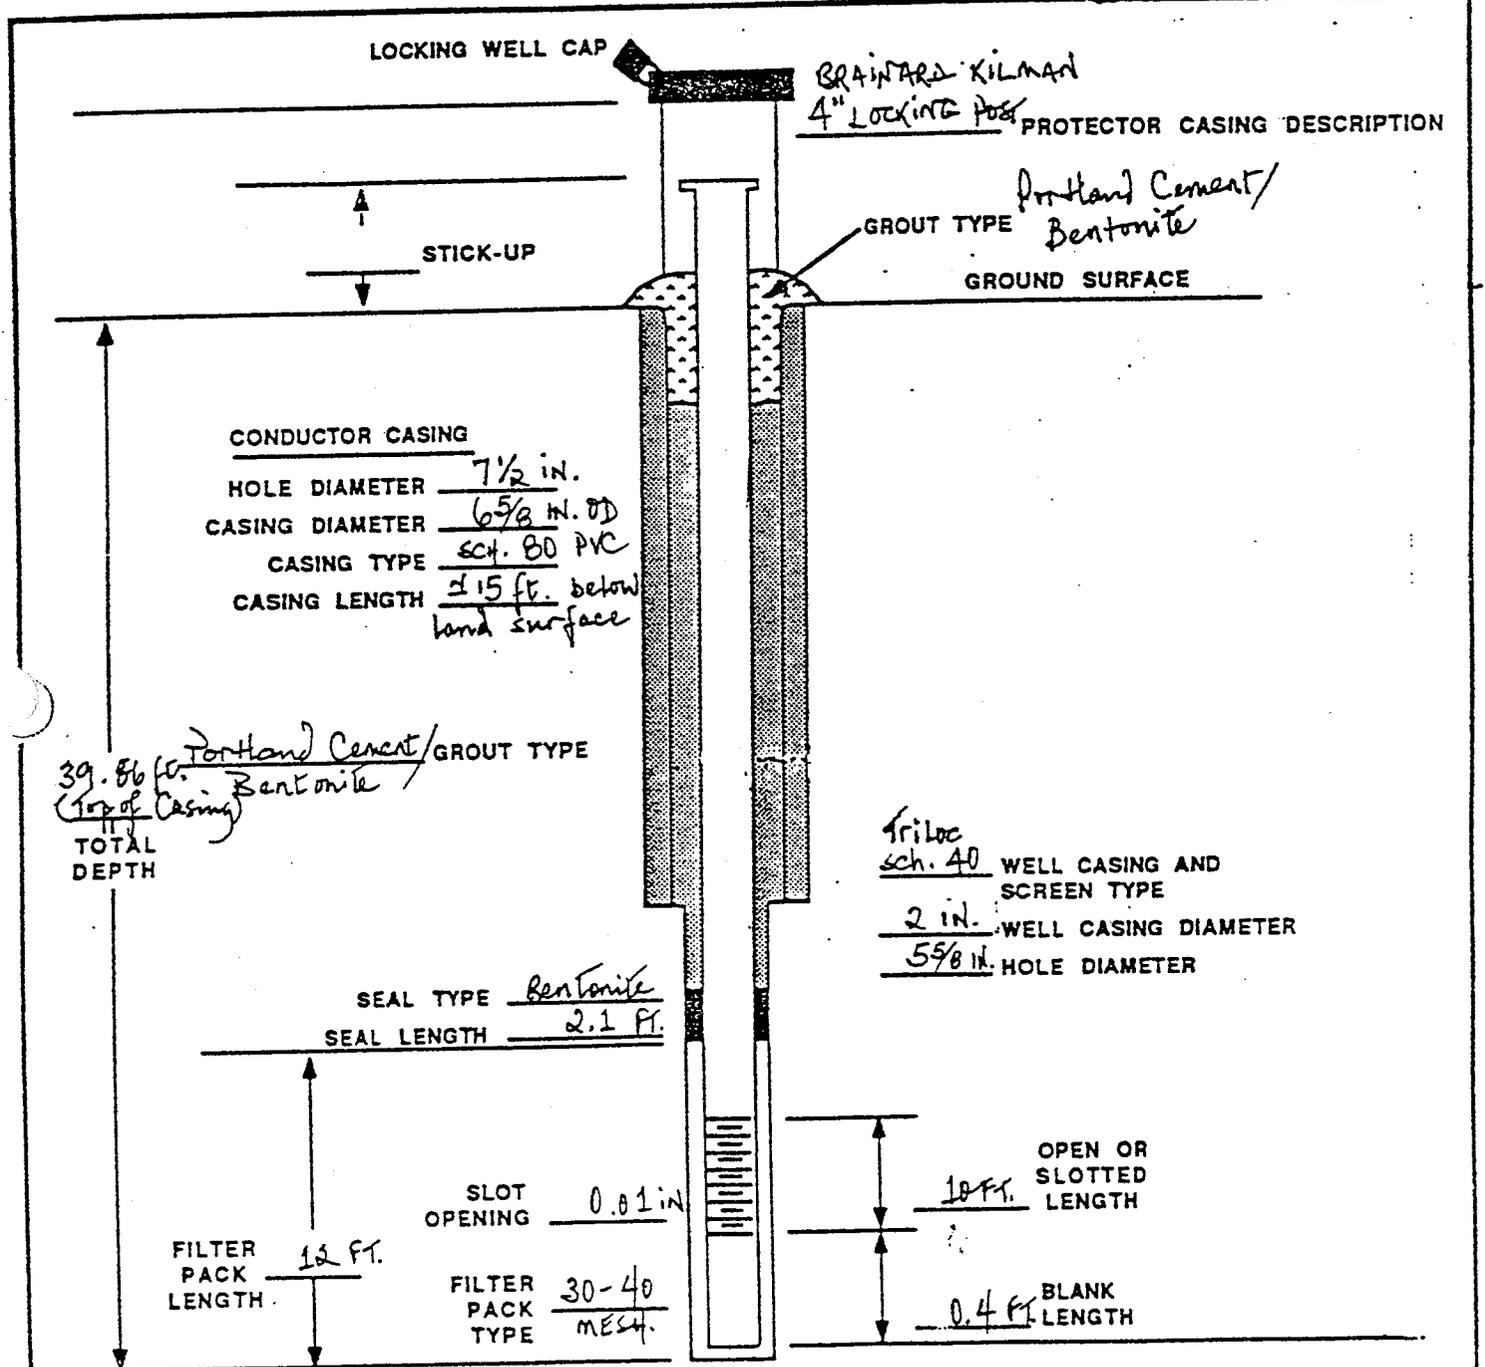

COMMENTS: An upper casing was set into a stiff, fat clay (CH). The well was developed using a B-K submersible hand pump.

PROJECT: Torrington/Sylvania
 LOCATION: Adjacent to W-15 and W-31
 WELL NUMBER: W-15D
 DATE INSTALLED: 3/21/89

ELEVATION:
 GROUND CASING PROTECTOR CASING
 ABOVE GROUND LEVEL ABOVE MEAN SEA LEVEL

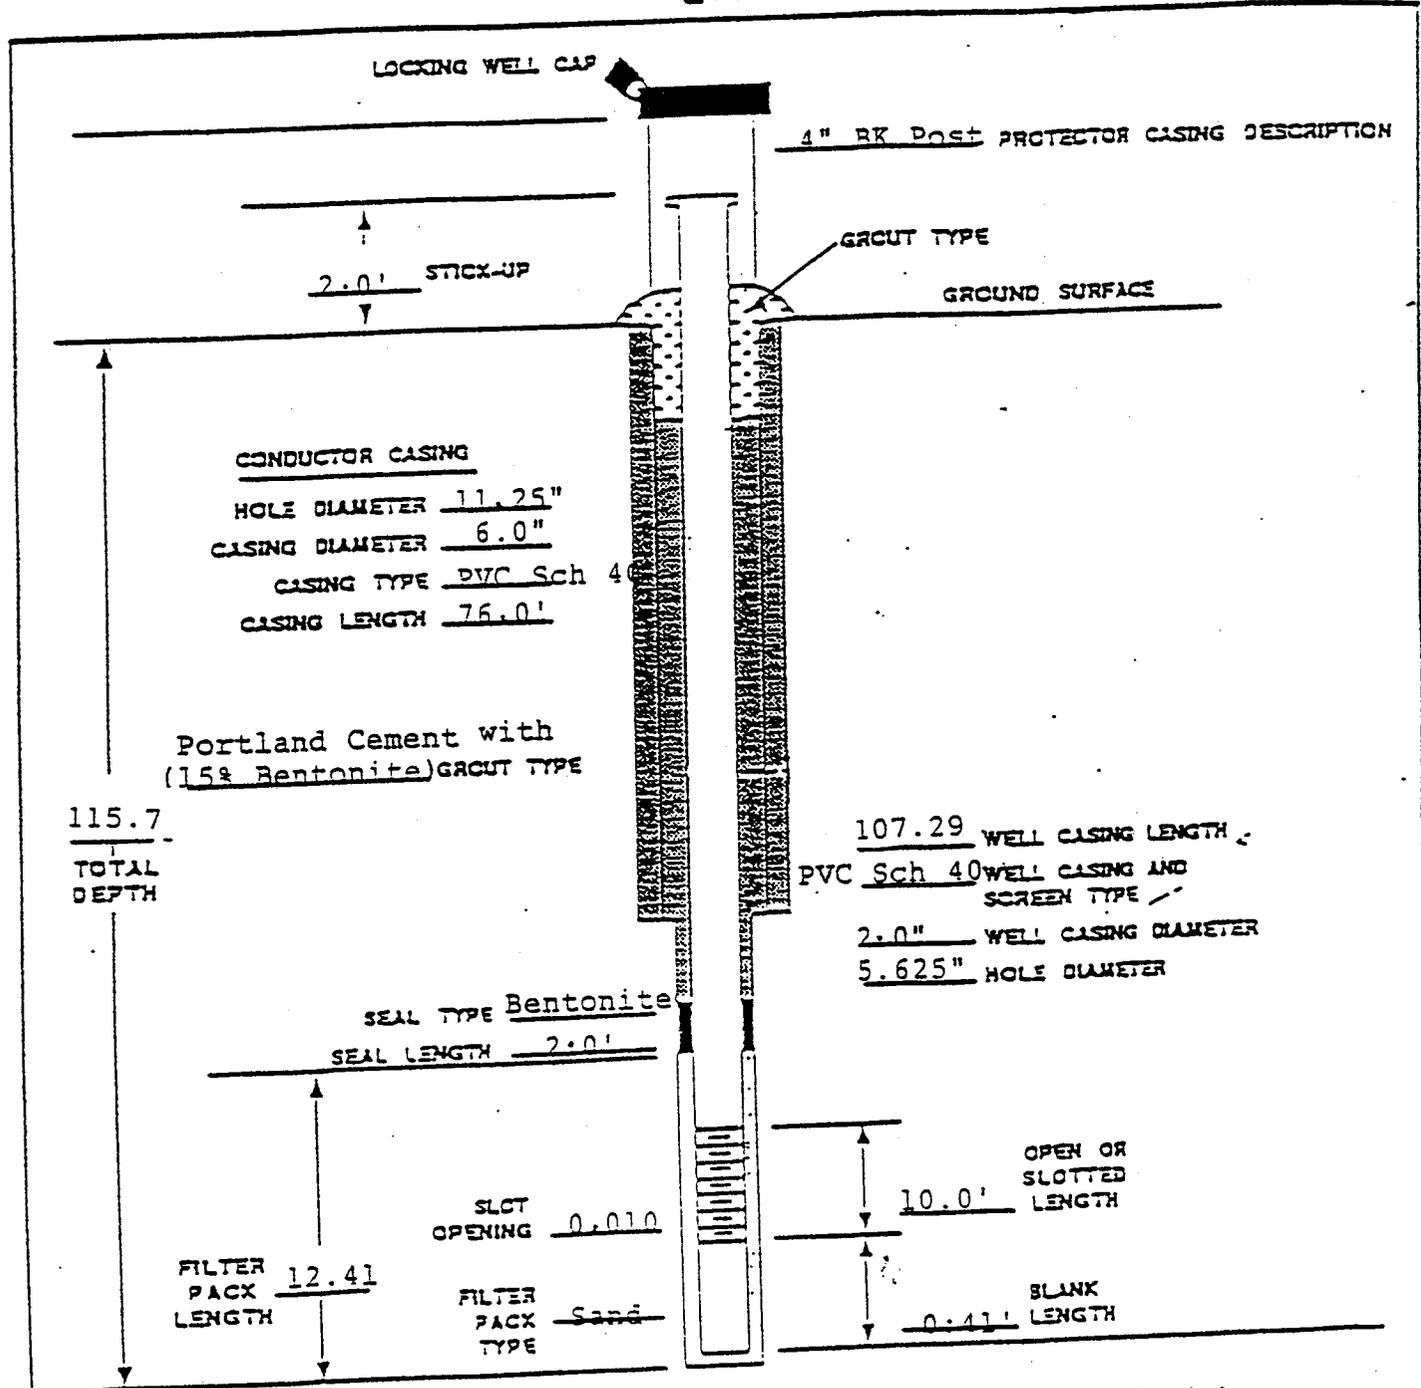


COMMENTS: Hole was drilled with mud rotary and cemented with
Portland cement and 5% Bentonite well was developed using
compressed air.

WELL CONSTRUCTION DIAGRAM

PROJECT: TORRINGTON
 LOCATION: Sylvania, GA
 WELL NUMBER: W-16
 DATE INSTALLED: July 23, 1987


ELEVATION: 149.20
 GROUND CASING PROTECTOR CASING
 ABOVE GROUND LEVEL ABOVE MEAN SEA LEVEL

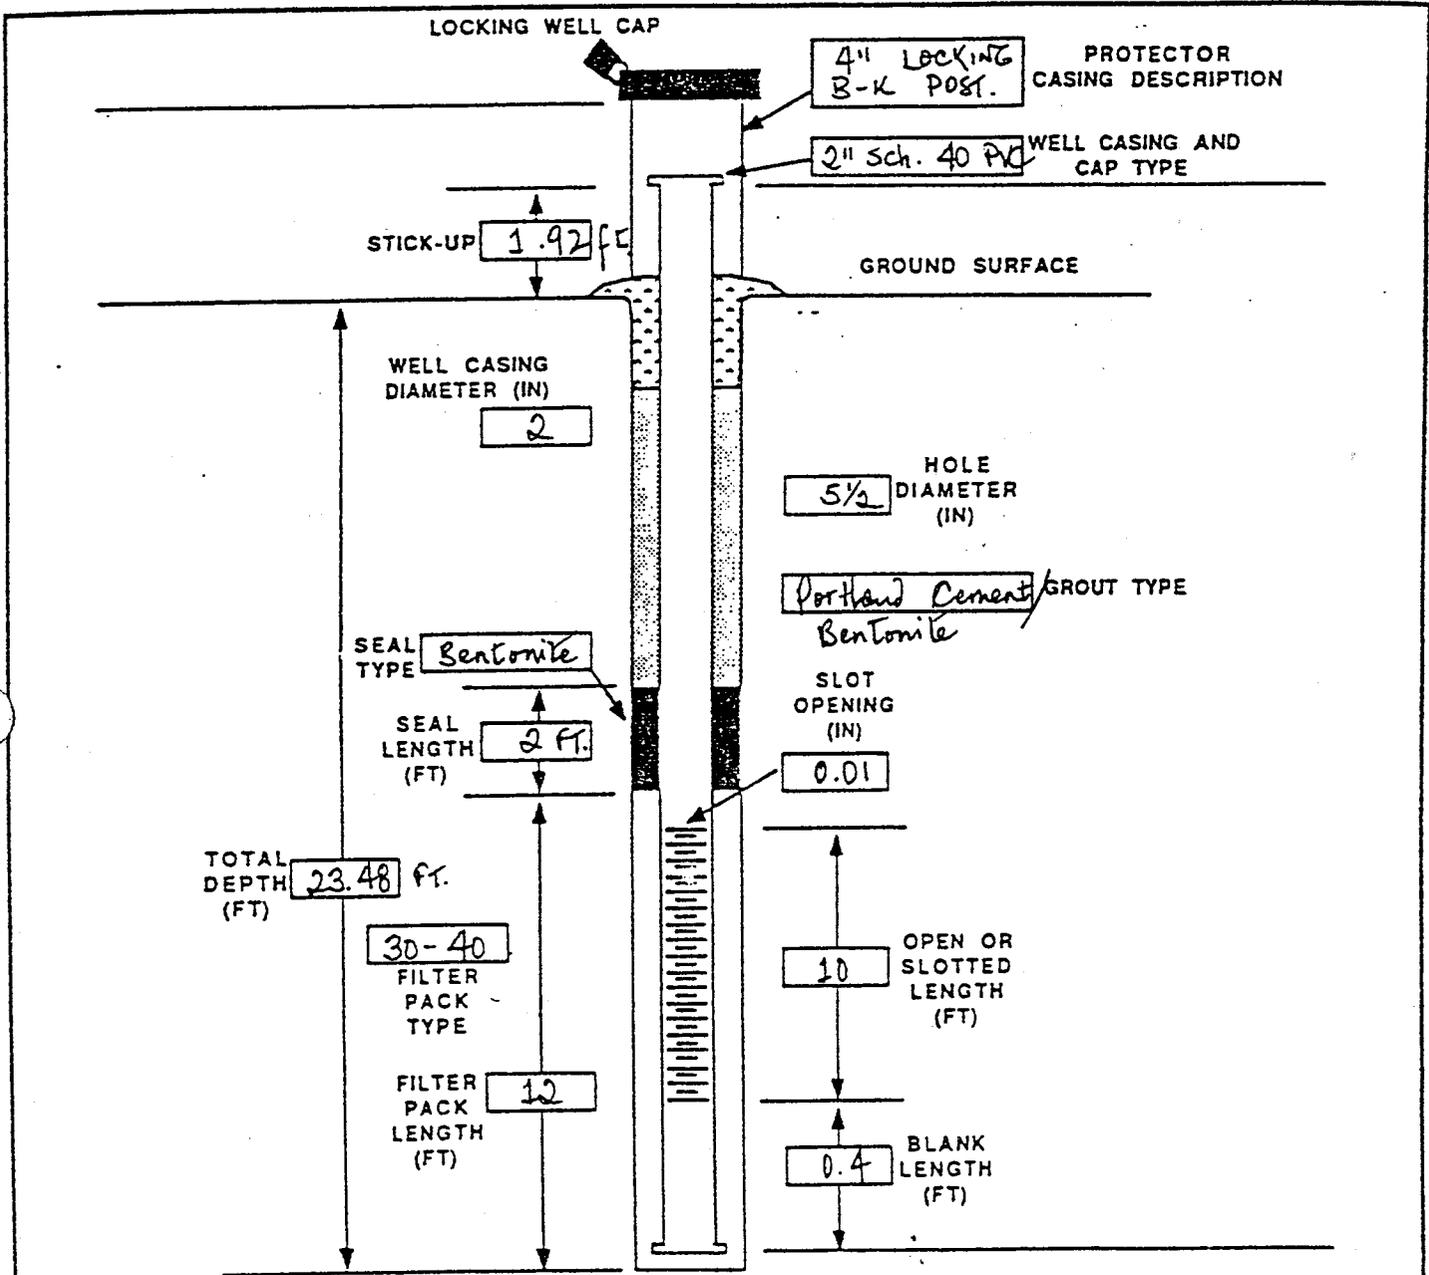

COMMENTS: The well was developed using bailing and a submersible Bramar - Kilman hand pump.

PROJECT: Torrington/Sylvania
 LOCATION: Adjacent to W-16 and W-16D
 WELL NUMBER: W-16DD
 DATE INSTALLED: 3-30-89


ELEVATION:
 GROUND CASING PROTECTOR CASING
 ABOVE GROUND LEVEL ABOVE MEAN SEA LEVEL

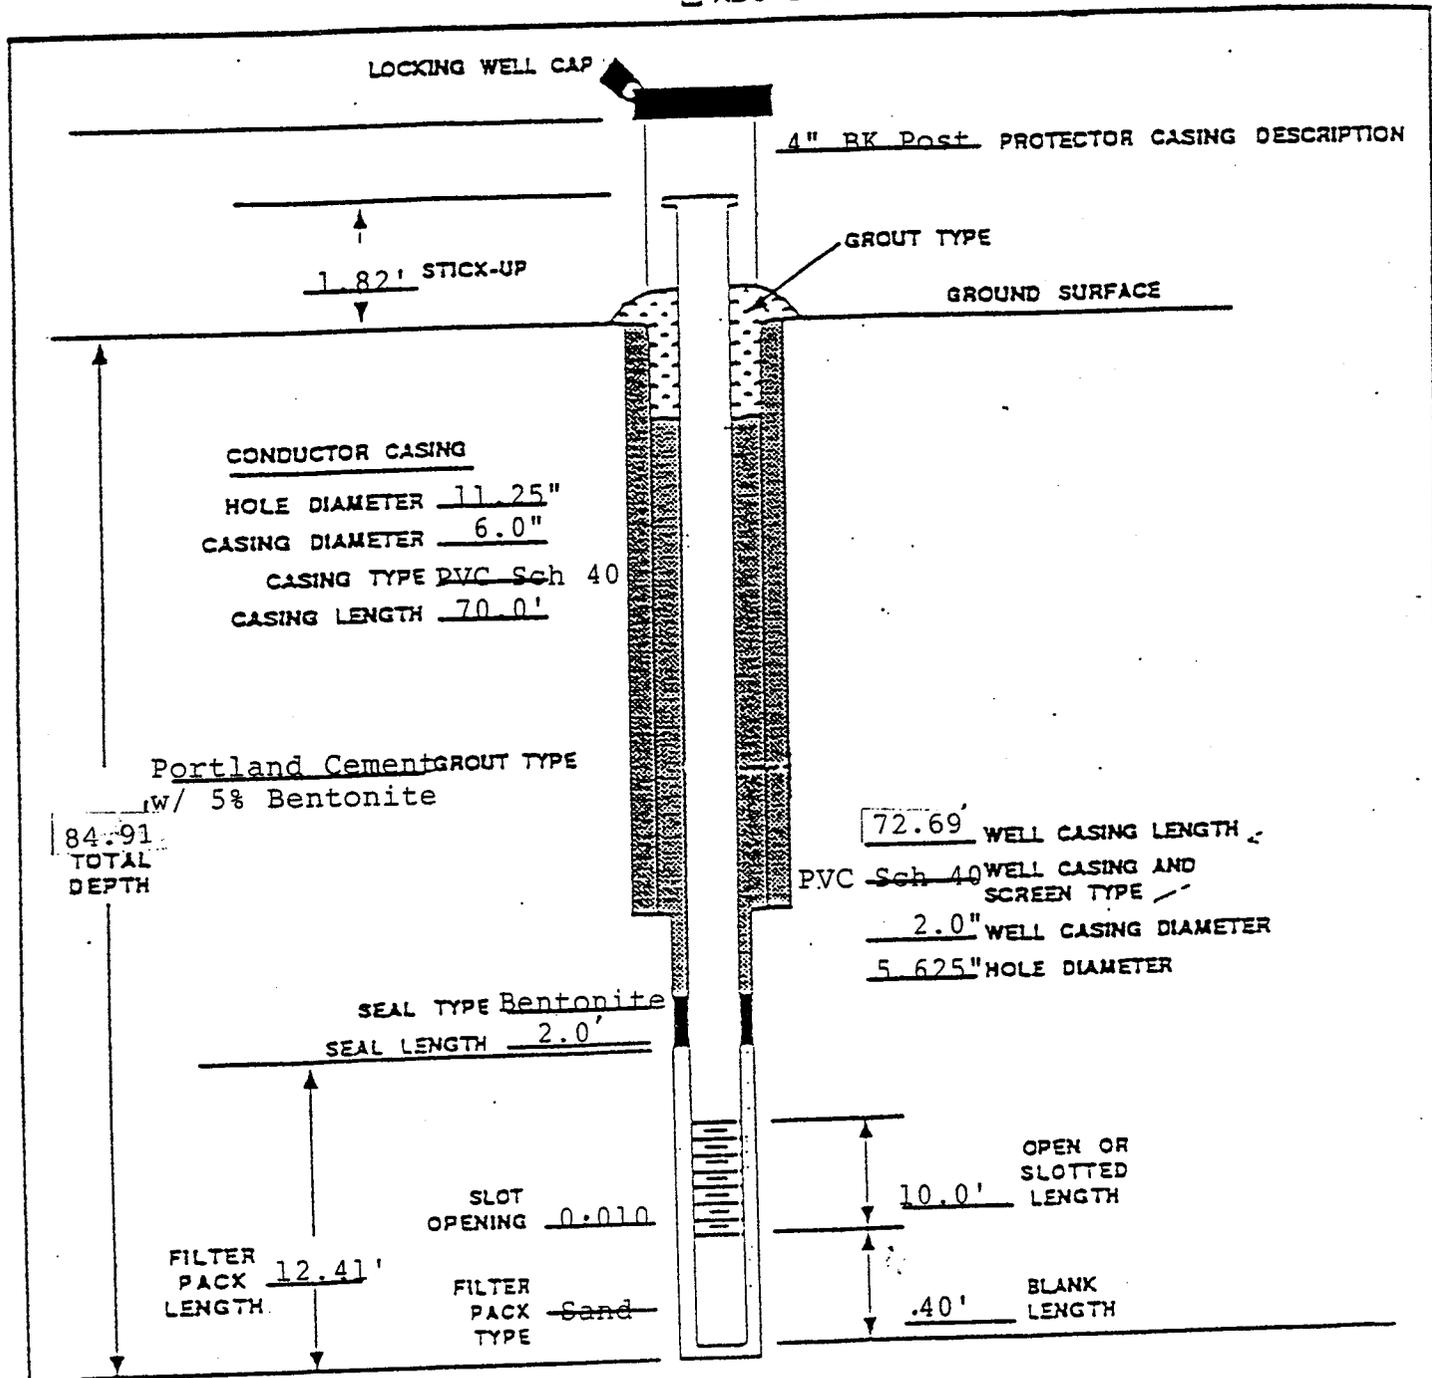

COMMENTS: Conductor hole was drilled with 11-1/4" drag bit using mud rotary. Casing was cemented using 1" Tremie pipe. Bottom section was also drilled using mud rotary. Well was developed using air.

OBJECT: TORRINGTON JOB NUMBER: _____
 LOCATION: SYLVANIA, GA.
 WELL NUMBER: N-17 ELEVATION: 156.0
 DATE INSTALLED: 7-24-87


GROUND CASING PROTECTOR CASING
 ABOVE GROUND LEVEL ABOVE MEAN SEA LEVEL

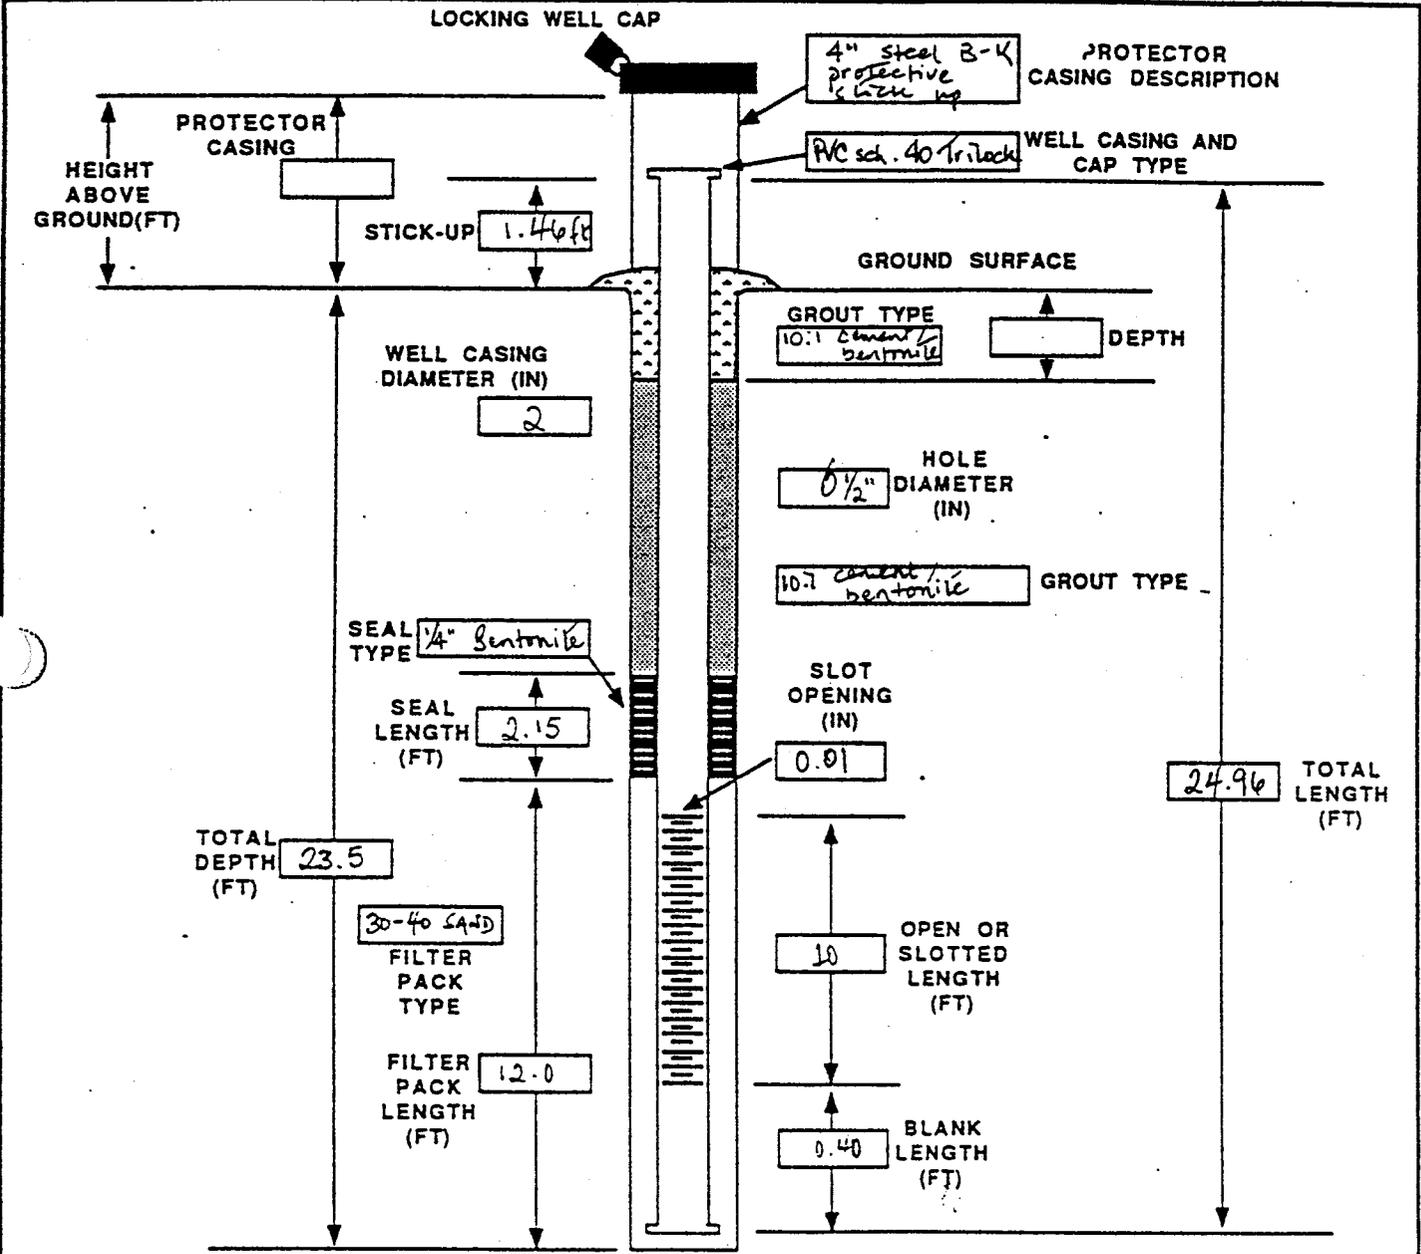

COMMENTS: per PCA standards.

PROJECT: Torrington/Sylvania
 LOCATION: Adjacent to W-17
 WELL NUMBER: 17D
 DATE INSTALLED: 3-2-89

ELEVATION: _____
 GROUND CASING PROTECTOR CASING
 ABOVE GROUND LEVEL ABOVE MEAN SEA LEVEL

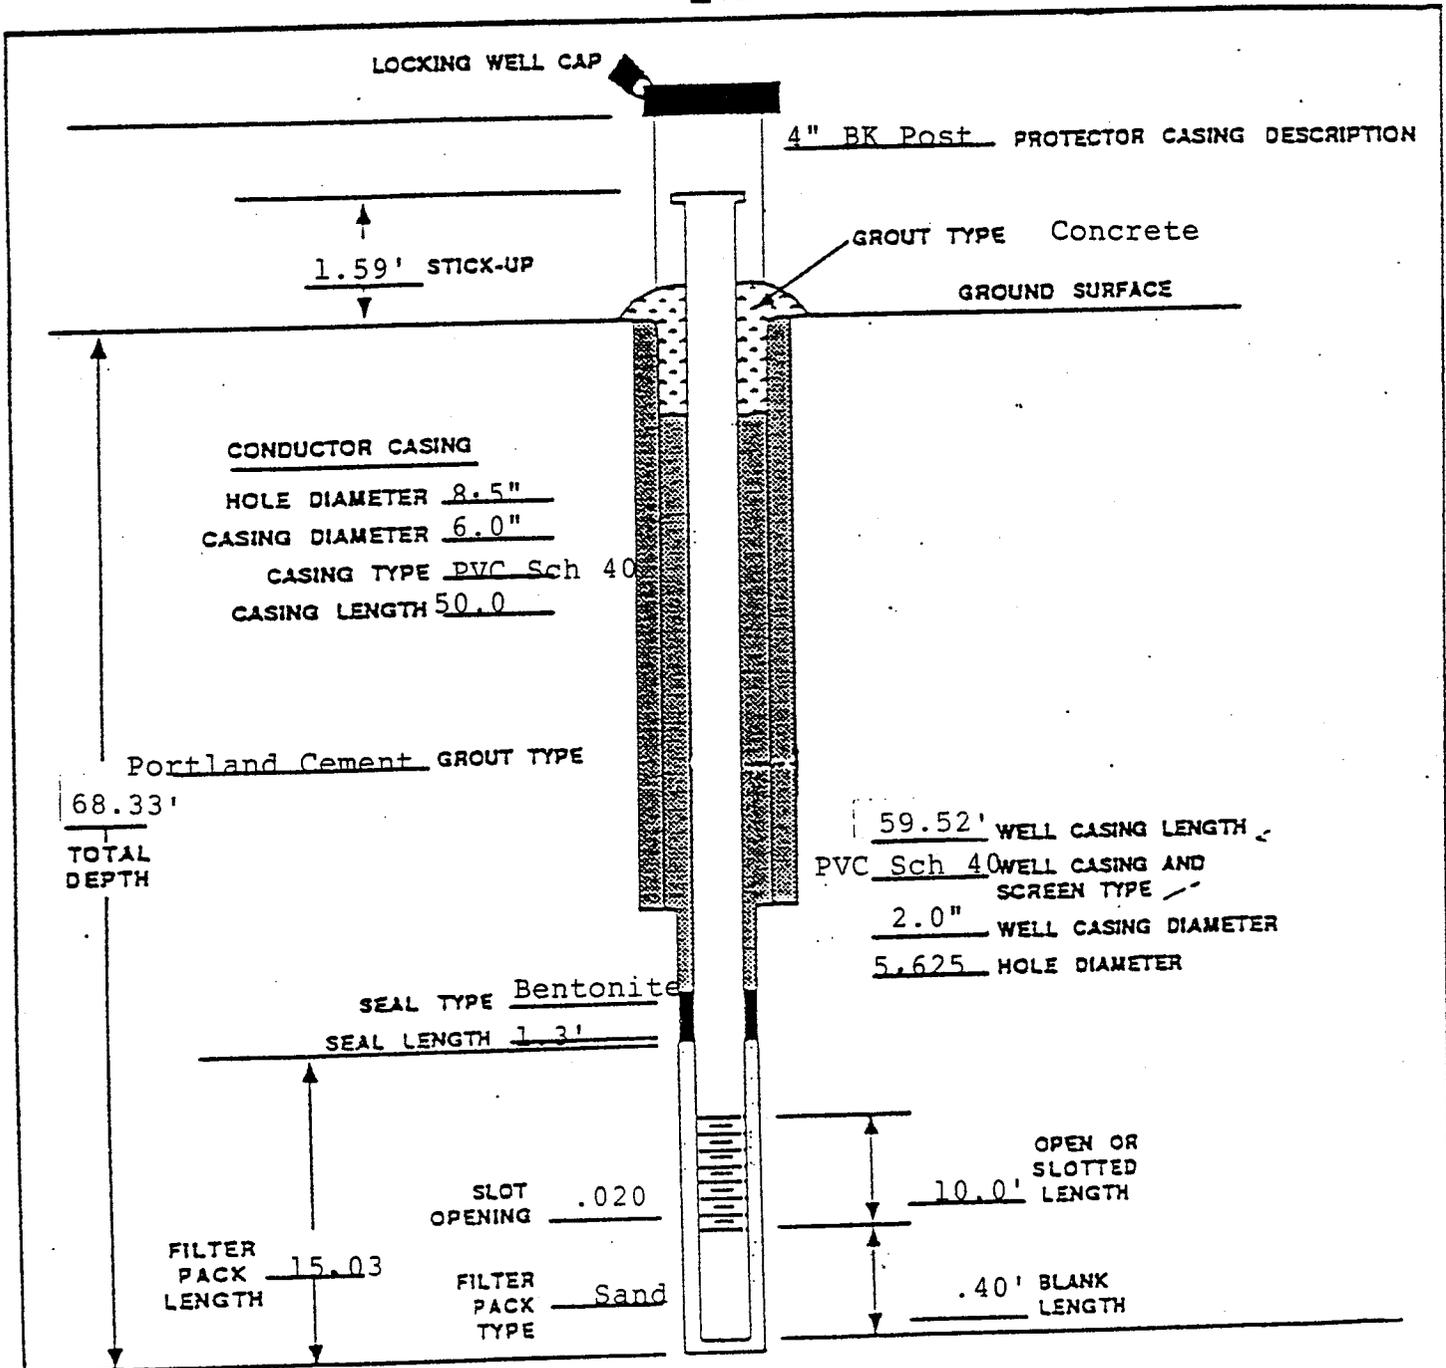

COMMENTS: Conductor hole was mud rotary drilled using 5-5/8" bit with
8-1/2" reamer 6" casing was cemented using 1" trimie pipe.
Bottom section of well was also mud rotary drilled with 5-5/8"
bit and casing was cemented using 1" Trimie pipe. Well was
developed using B-K submersable hand pump.

PROJECT: Torrington Co.


LOCATION: Sylvania, GA

WELL NUMBER: W-13

DATE INSTALLED: July 25-26, 1988

ELEVATION: 164.65 feet


GROUND CASING PROTECTOR CASING
 ABOVE GROUND LEVEL ABOVE MEAN SEA LEVEL

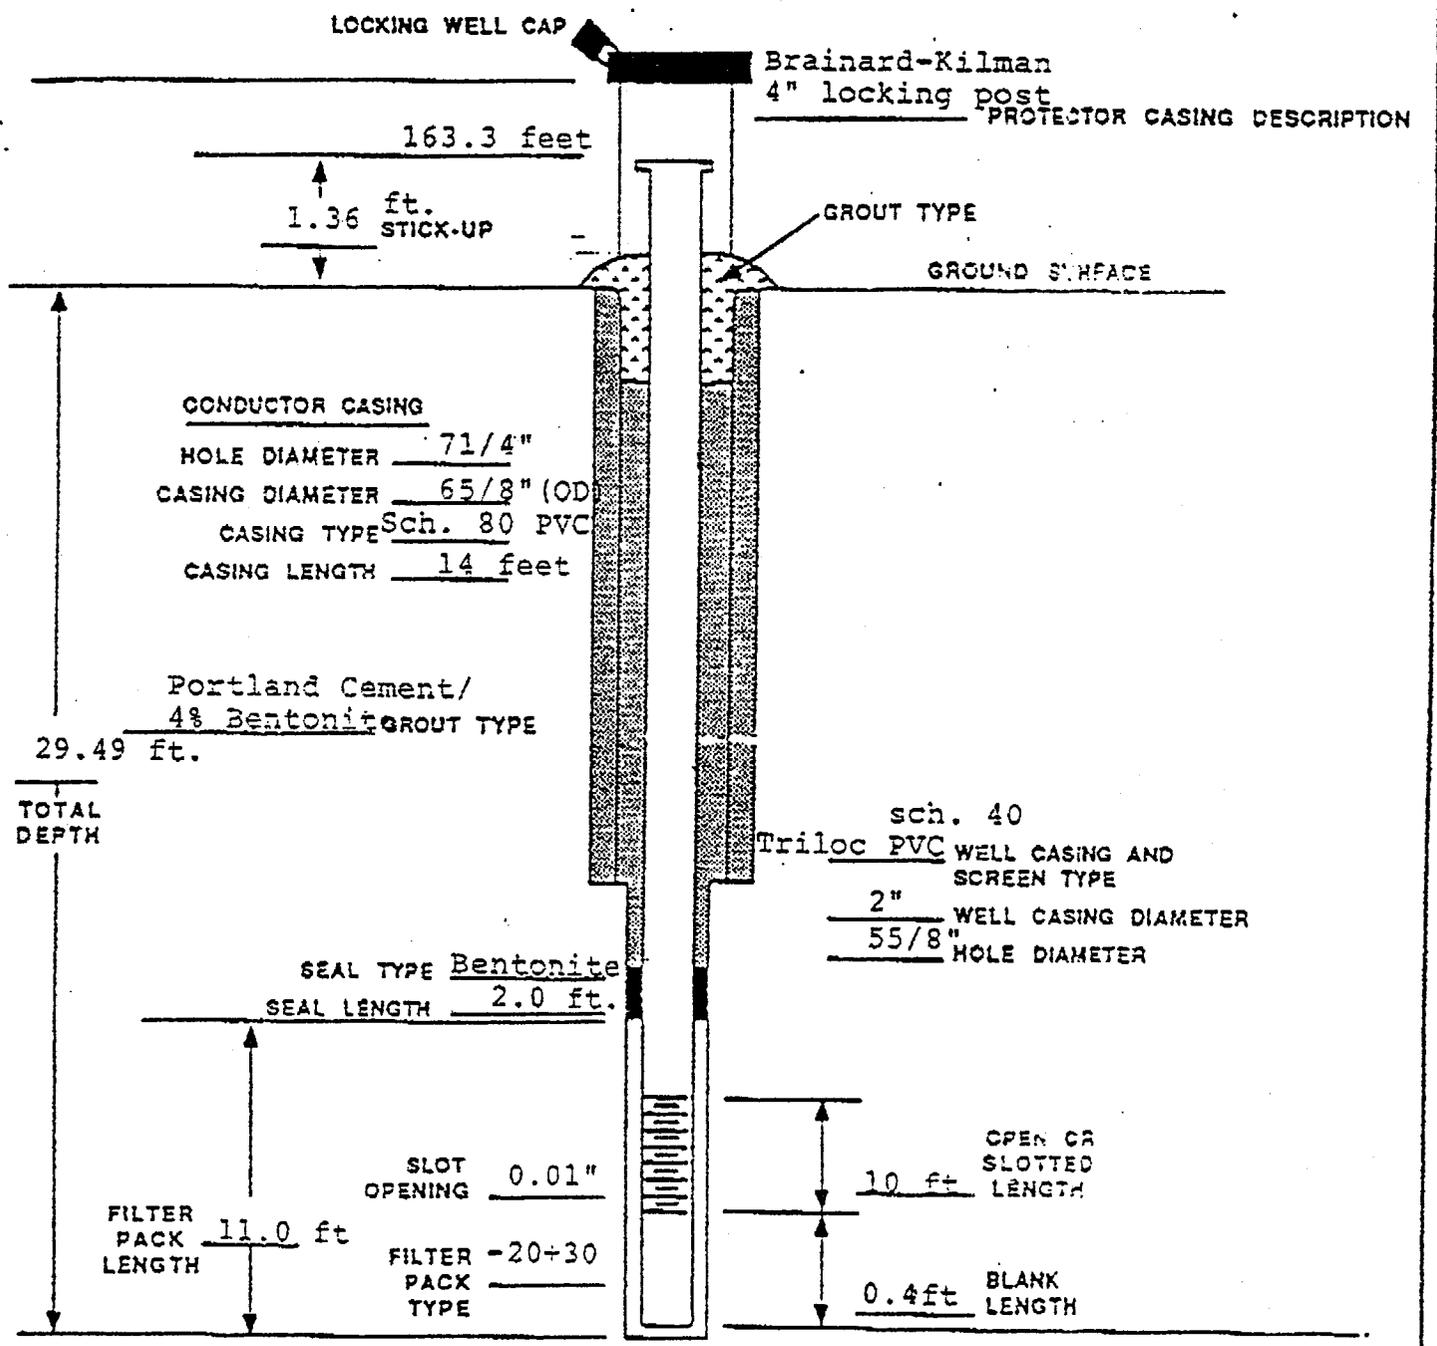

COMMENTS: An outer casing was set into the clay layer encountered at 13 feet. The outer casing was sealed and the well was drilled to total depth using mud rotary drilling with no mud added. The well was developed using a Brainard- Kilman submersible hand pump.

WELL CONSTRUCTION DIAGRAM


PROJECT: TORRINGTON
 LOCATION: SYLVANIA, GA.
 WELL NUMBER: W-29 ELEVATION: 147.0 FT.
 DATE INSTALLED: MARCH 29 - April 1, 1988 GROUND CASING PROTECTOR CASING
 ABOVE GROUND LEVEL ABOVE MEAN SEA LEVEL

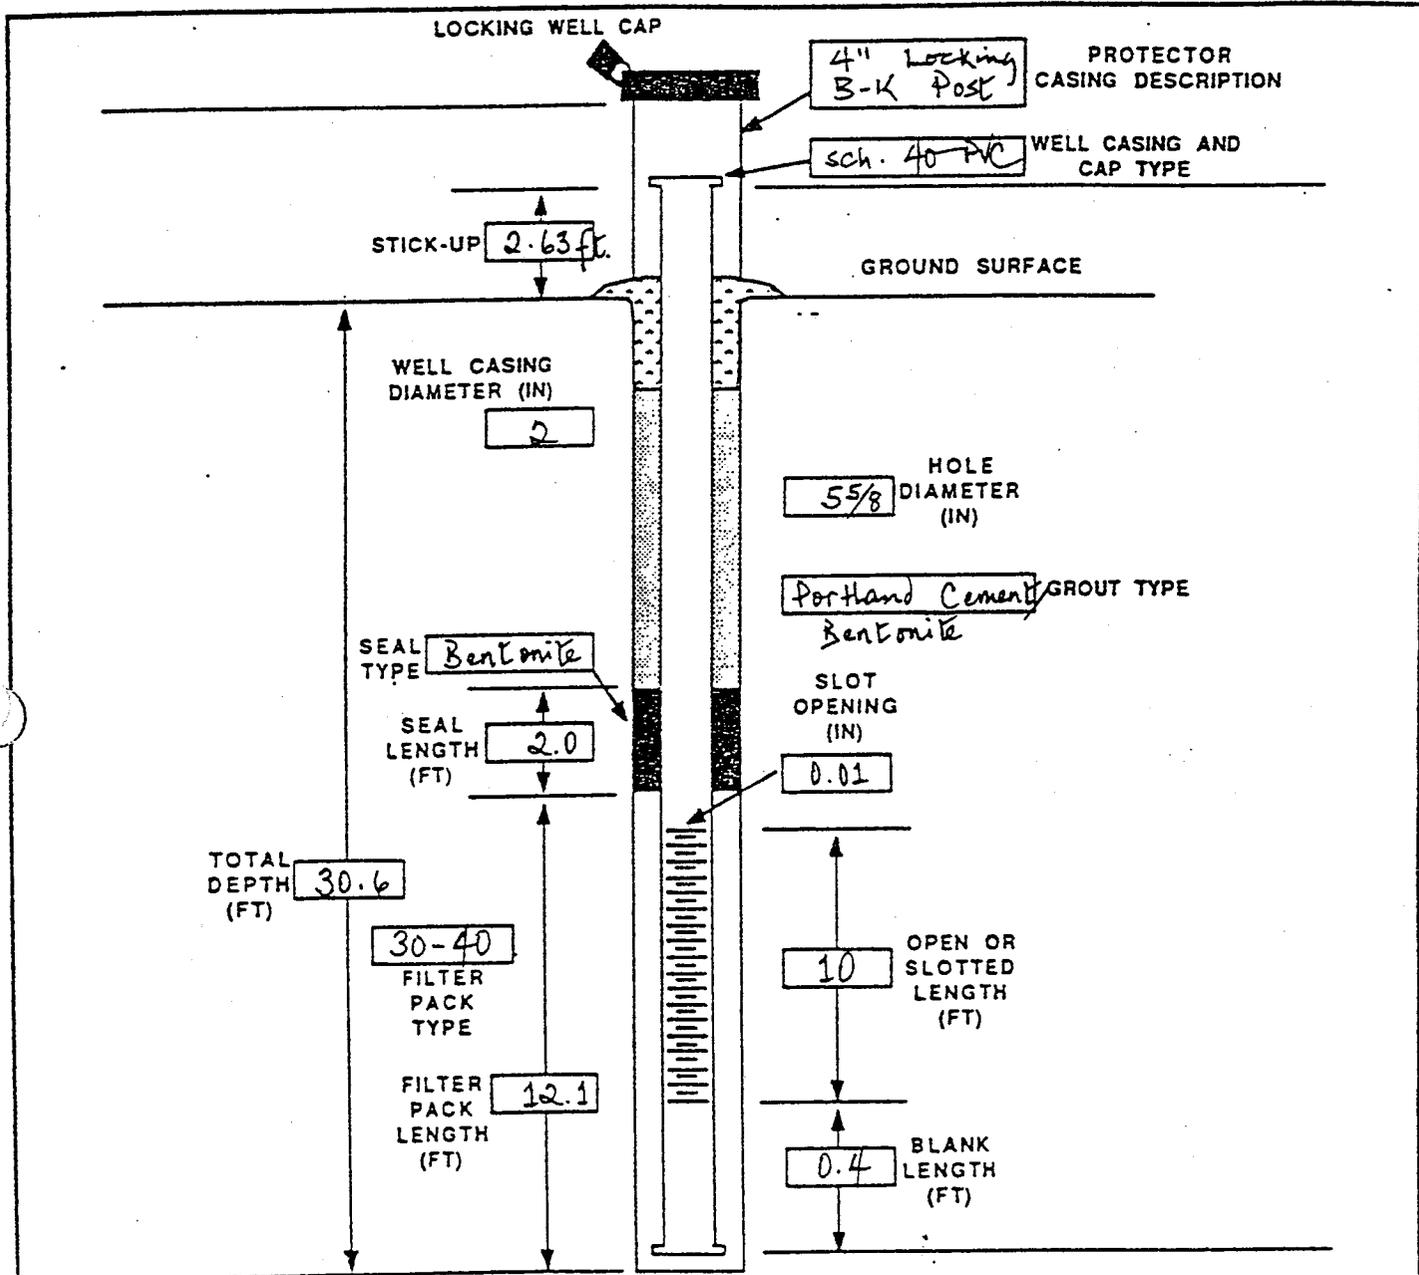

COMMENTS: The well was developed using a submersible
Bramard - Kilman hand pump.

WELL CONSTRUCTION DIAGRAM


PROJECT: Torrington Co.
 LOCATION: Sylvania, GA
 WELL NUMBER: W-20S ELEVATION: 130.1 Ft. AMSL
 DATE INSTALLED: March 26, 1988 GROUND CASING PROTECTOR CASING
 ABOVE GROUND LEVEL ABOVE MEAN SEA LEVEL

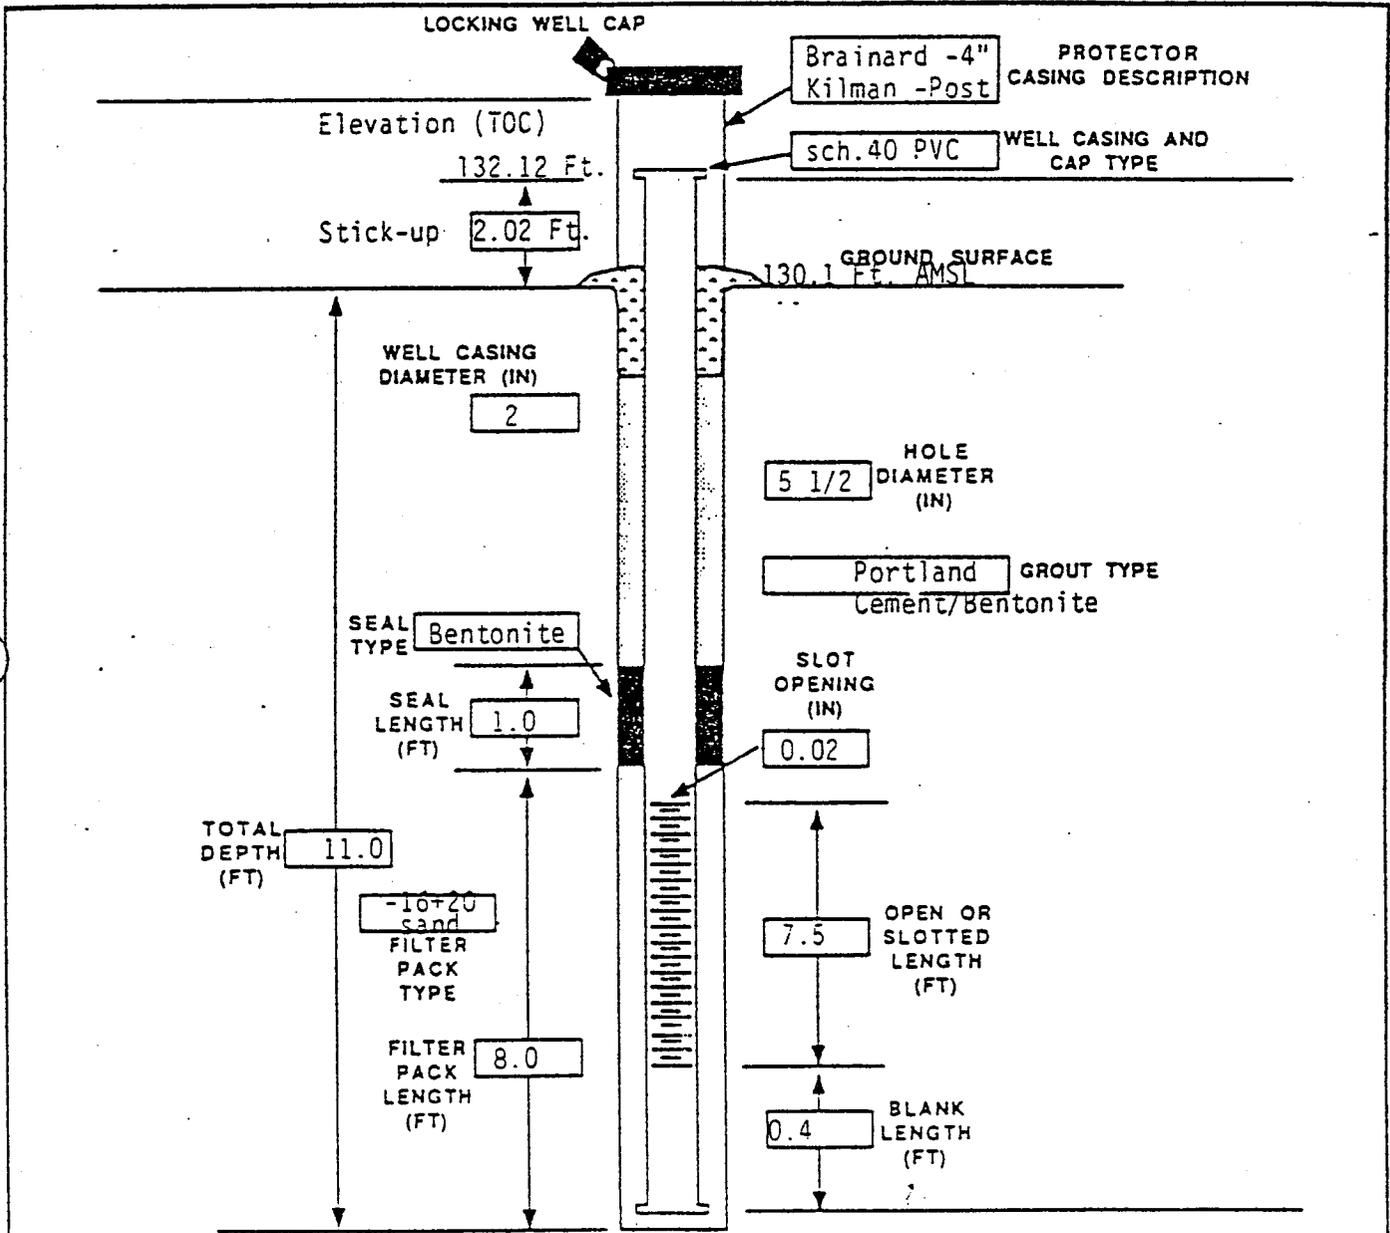

COMMENTS: Well was installed adjacent to W-20D using hollow stem augers. The well was seated into a low permeability unit (SC-CL). The well was developed by bailing until the water had cleared.


WELL CONSTRUCTION DIAGRAM

PROJECT: Torrington
 LOCATION: Sylvania, GA
 WELL NUMBER: W-200 ELEVATION: 130.0 Ft.
 DATE INSTALLED: March 23-25, 1988 GROUND CASING PROTECTOR CASING
 ABOVE GROUND LEVEL ABOVE MEAN SEA LEVEL

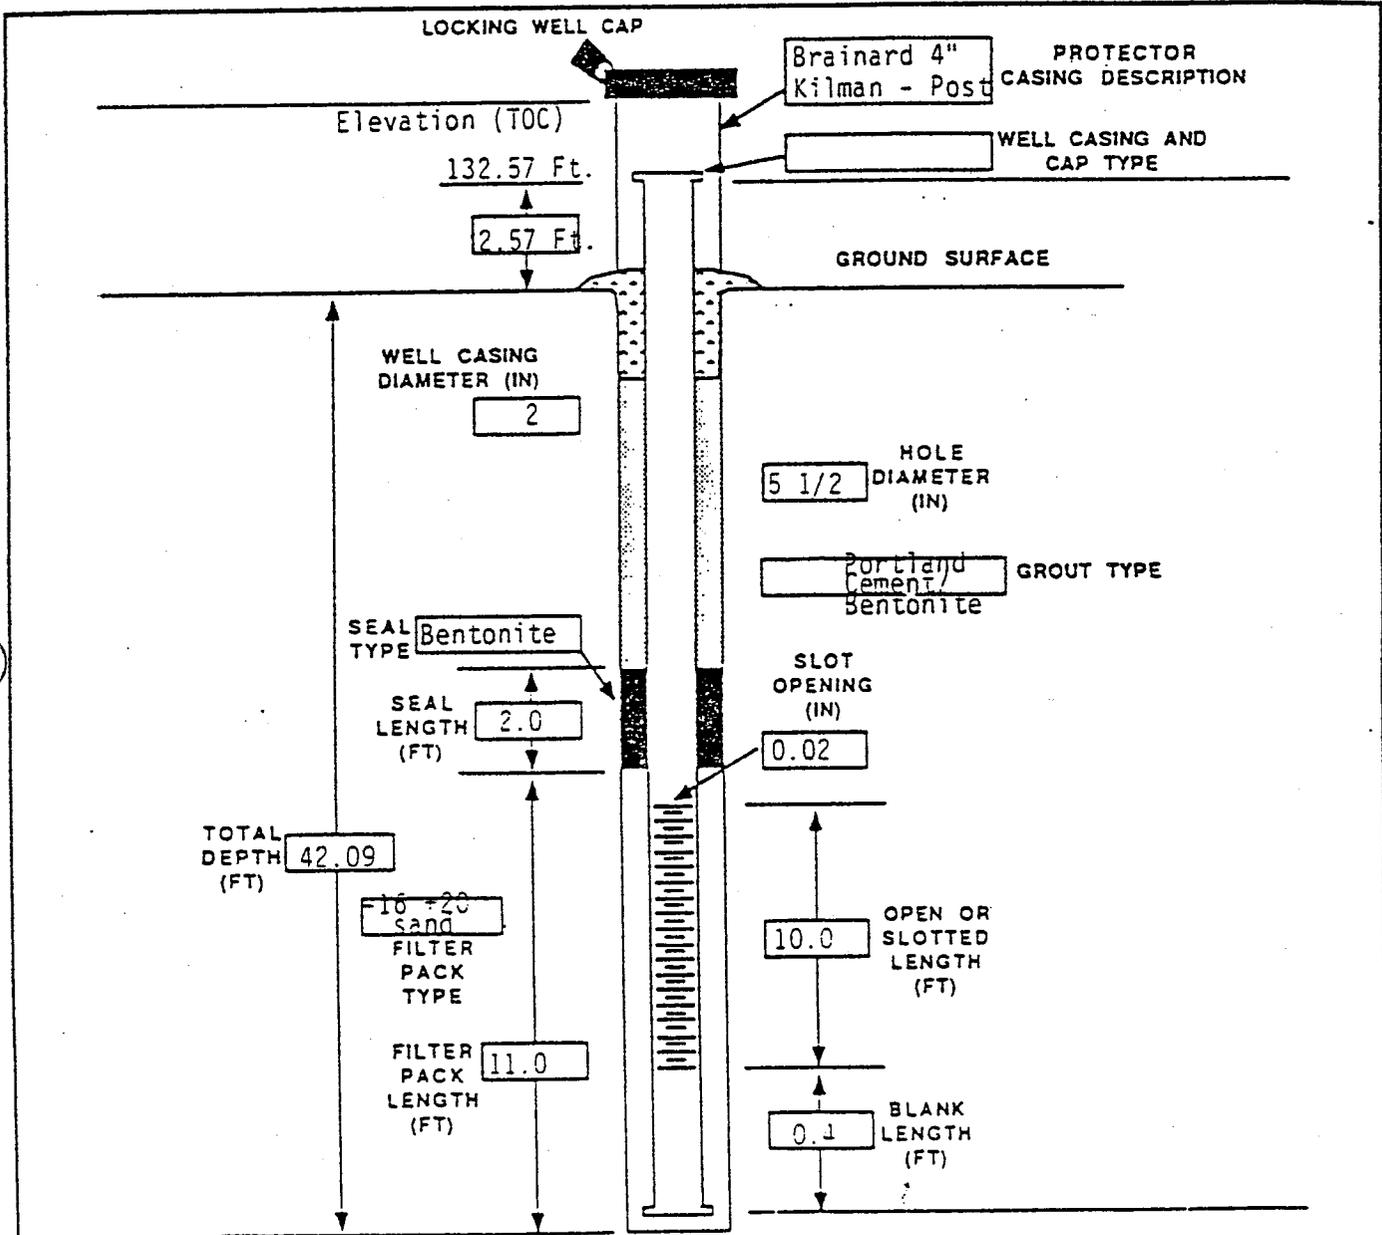

COMMENTS: The well was drilled using mud rotary drilling to a total depth of \approx 45 feet and backfilled to 42.1 feet with sand. The well was installed and then developed using both bailing and a Brainard-Kilman submersible hand pump.


PROJECT: Torrington Co.
 LOCATION: Sylvania, GA
 WELL NUMBER: W-2000 ELEVATION: ≈ 130 ft. AMSL
 DATE INSTALLED: April 29-May 1, 1988 GROUND CASING PROTECTOR CASING
 ABOVE GROUND LEVEL ABOVE MEAN SEA LEVEL

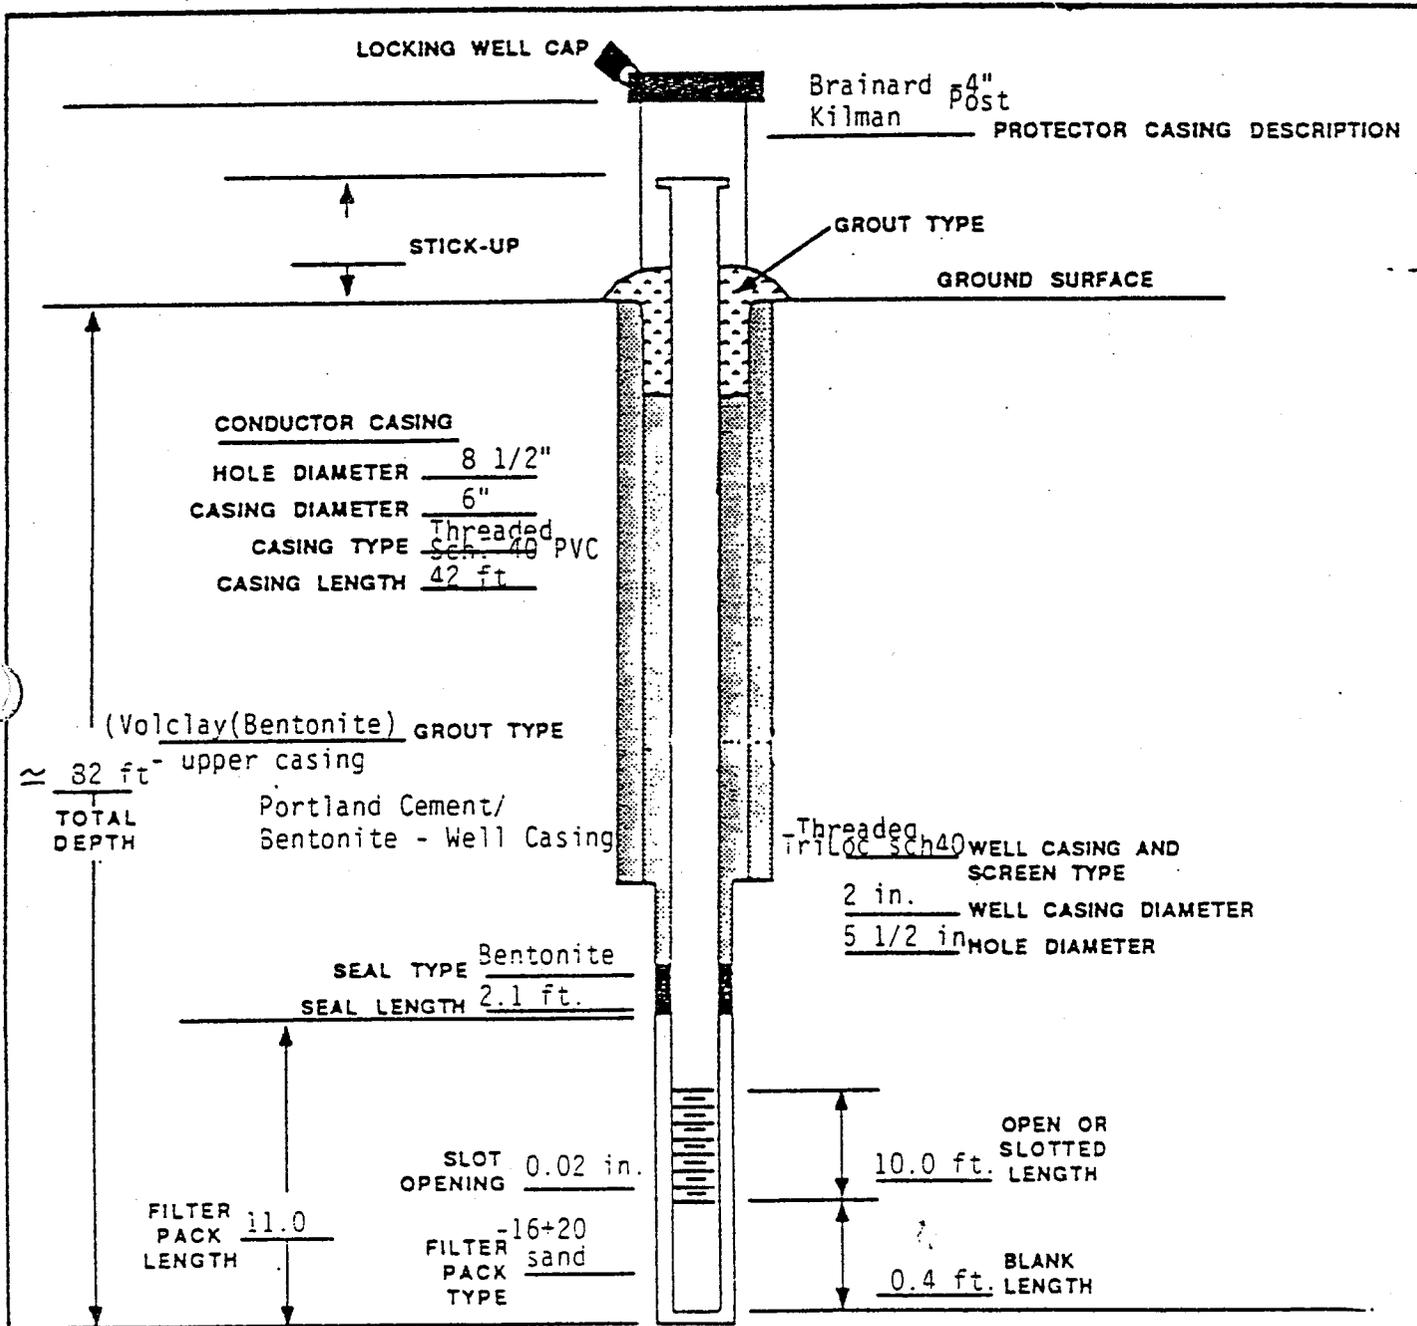

COMMENTS: The upper casing (6" sch. 40 PVC) was set to a depth of 42 feet below land surface. It was sealed in a volclay (bentonite) slurry and left over night. Drilling through the 6" casing continued until the total depth was reached (≈ 82 feet). The well was developed using a Brainard-Kilman submersible hand pump.

WELL CONSTRUCTION DIAGRAM


PROJECT: Torrington Co.
 LOCATION: Sylvania, GA
 WELL NUMBER: W-215 ELEVATION: 128.5 FT. AMSL
 DATE INSTALLED: March 17-19 1988 GROUND CASING PROTECTOR CASING
 ABOVE GROUND LEVEL ABOVE MEAN SEA LEVEL

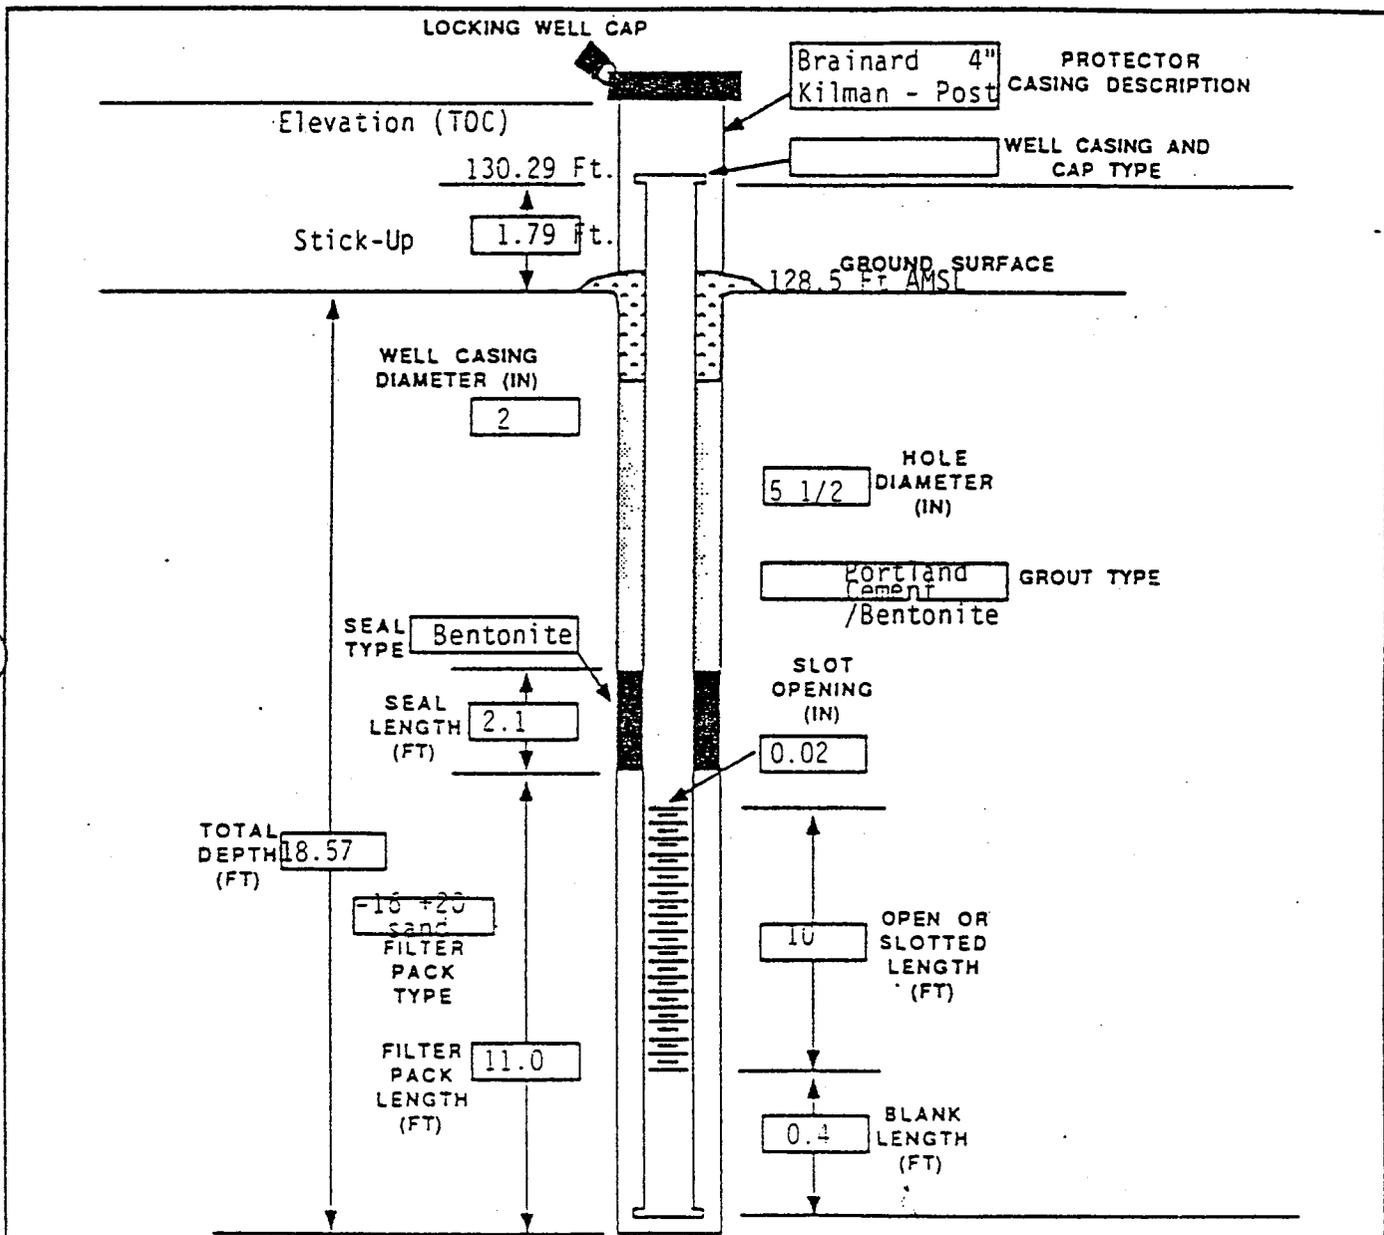

COMMENTS: The hole was drilled using hollow stem auger. The well was installed and subsequently developed using a 2" bailer.


PROJECT: Torrington Co.
 LOCATION: Sylvania, GA
 WELL NUMBER: W-210
 DATE INSTALLED: March 20-22, 1988

ELEVATION: 128.5 Ft. AMSL
 GROUND CASING PROTECTOR CASING
 ABOVE GROUND LEVEL ABOVE MEAN SEA LEVEL

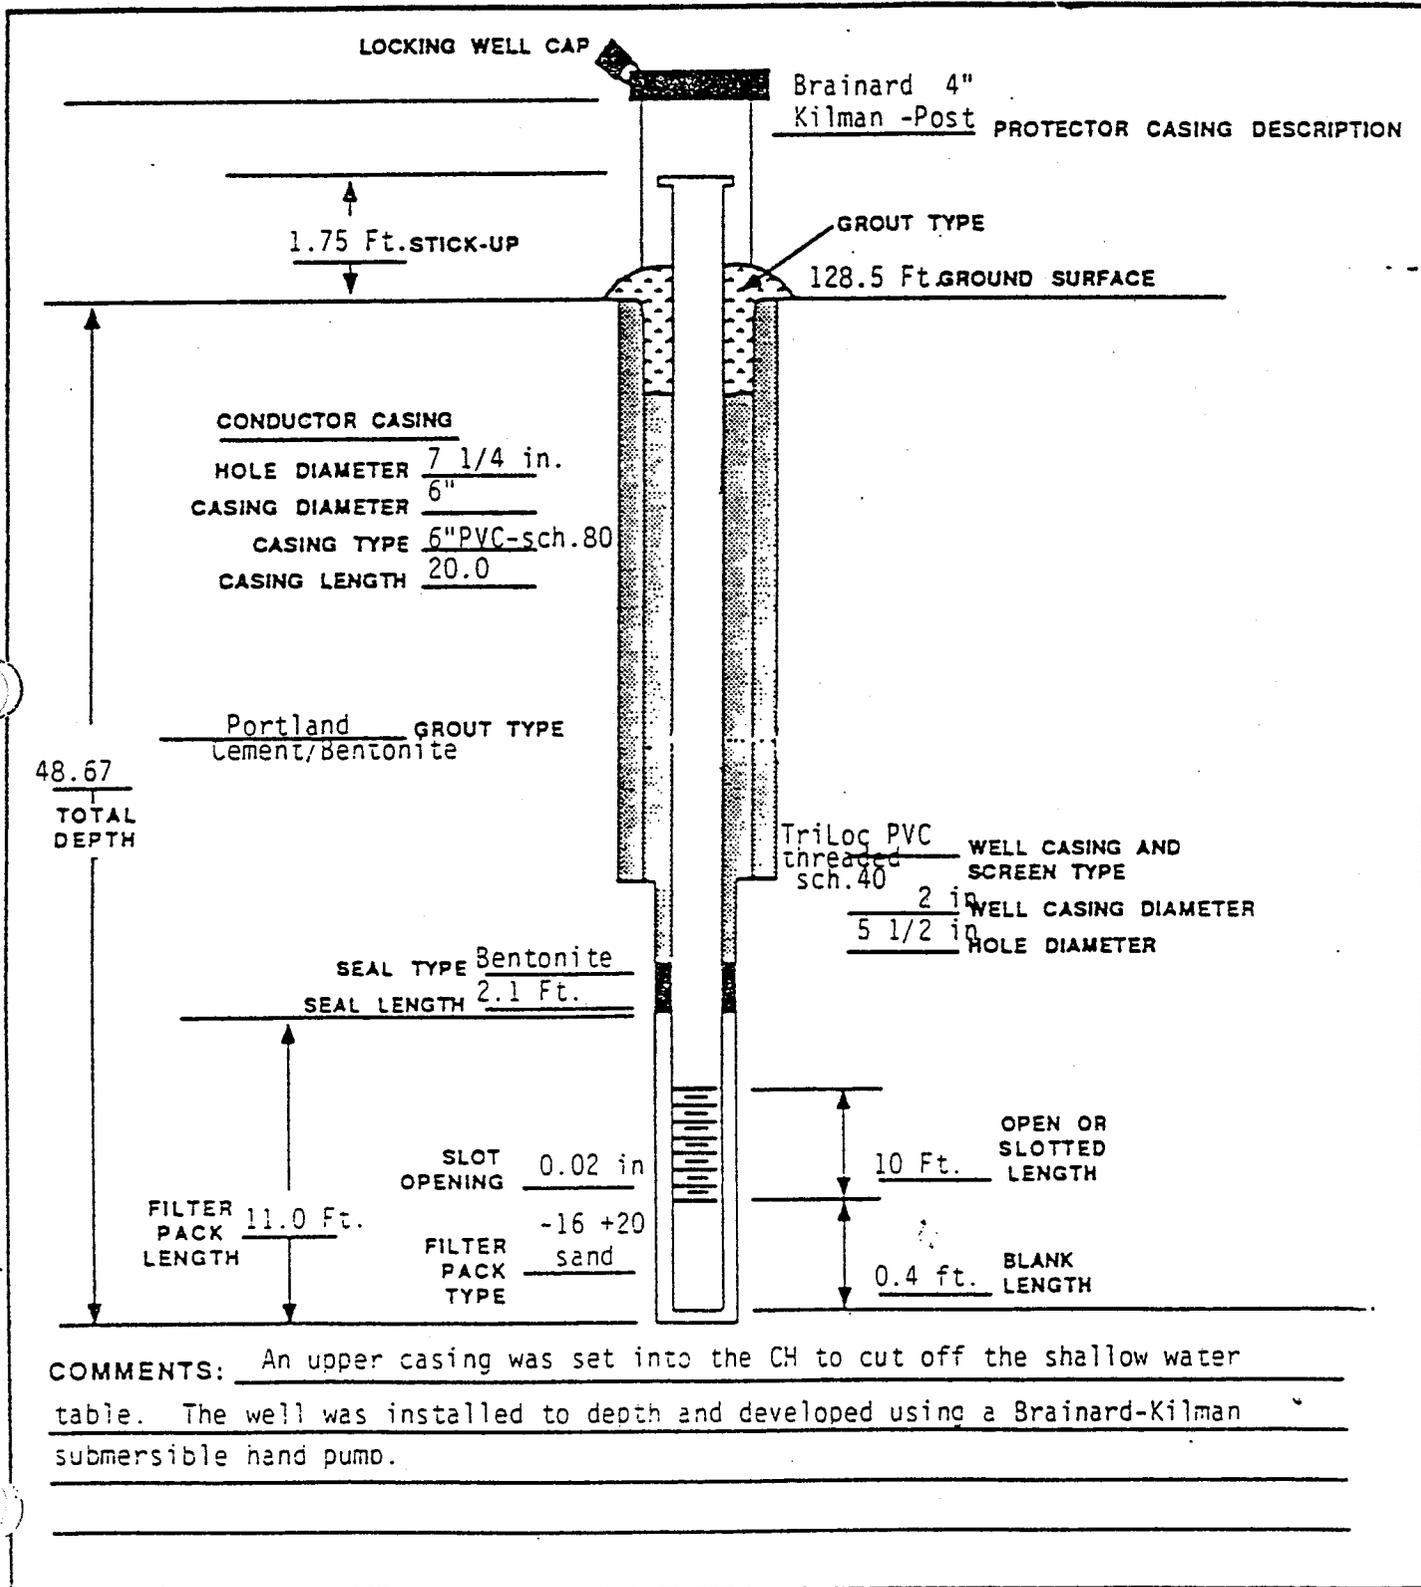

COMMENTS: An upper casing was set into the CH to cut off the shallow water table. The well was installed to depth and developed using a Brainard-Kilman submersible hand pump.


PROJECT: Torrington
 LOCATION: Sylvania, GA
 WELL NUMBER: W-27D ELEVATION: 183.7 Ft.
 DATE INSTALLED: April 13-14, 1988 GROUND CASING PROTECTOR CASING
 ABOVE GROUND LEVEL ABOVE MEAN SEA LEVEL

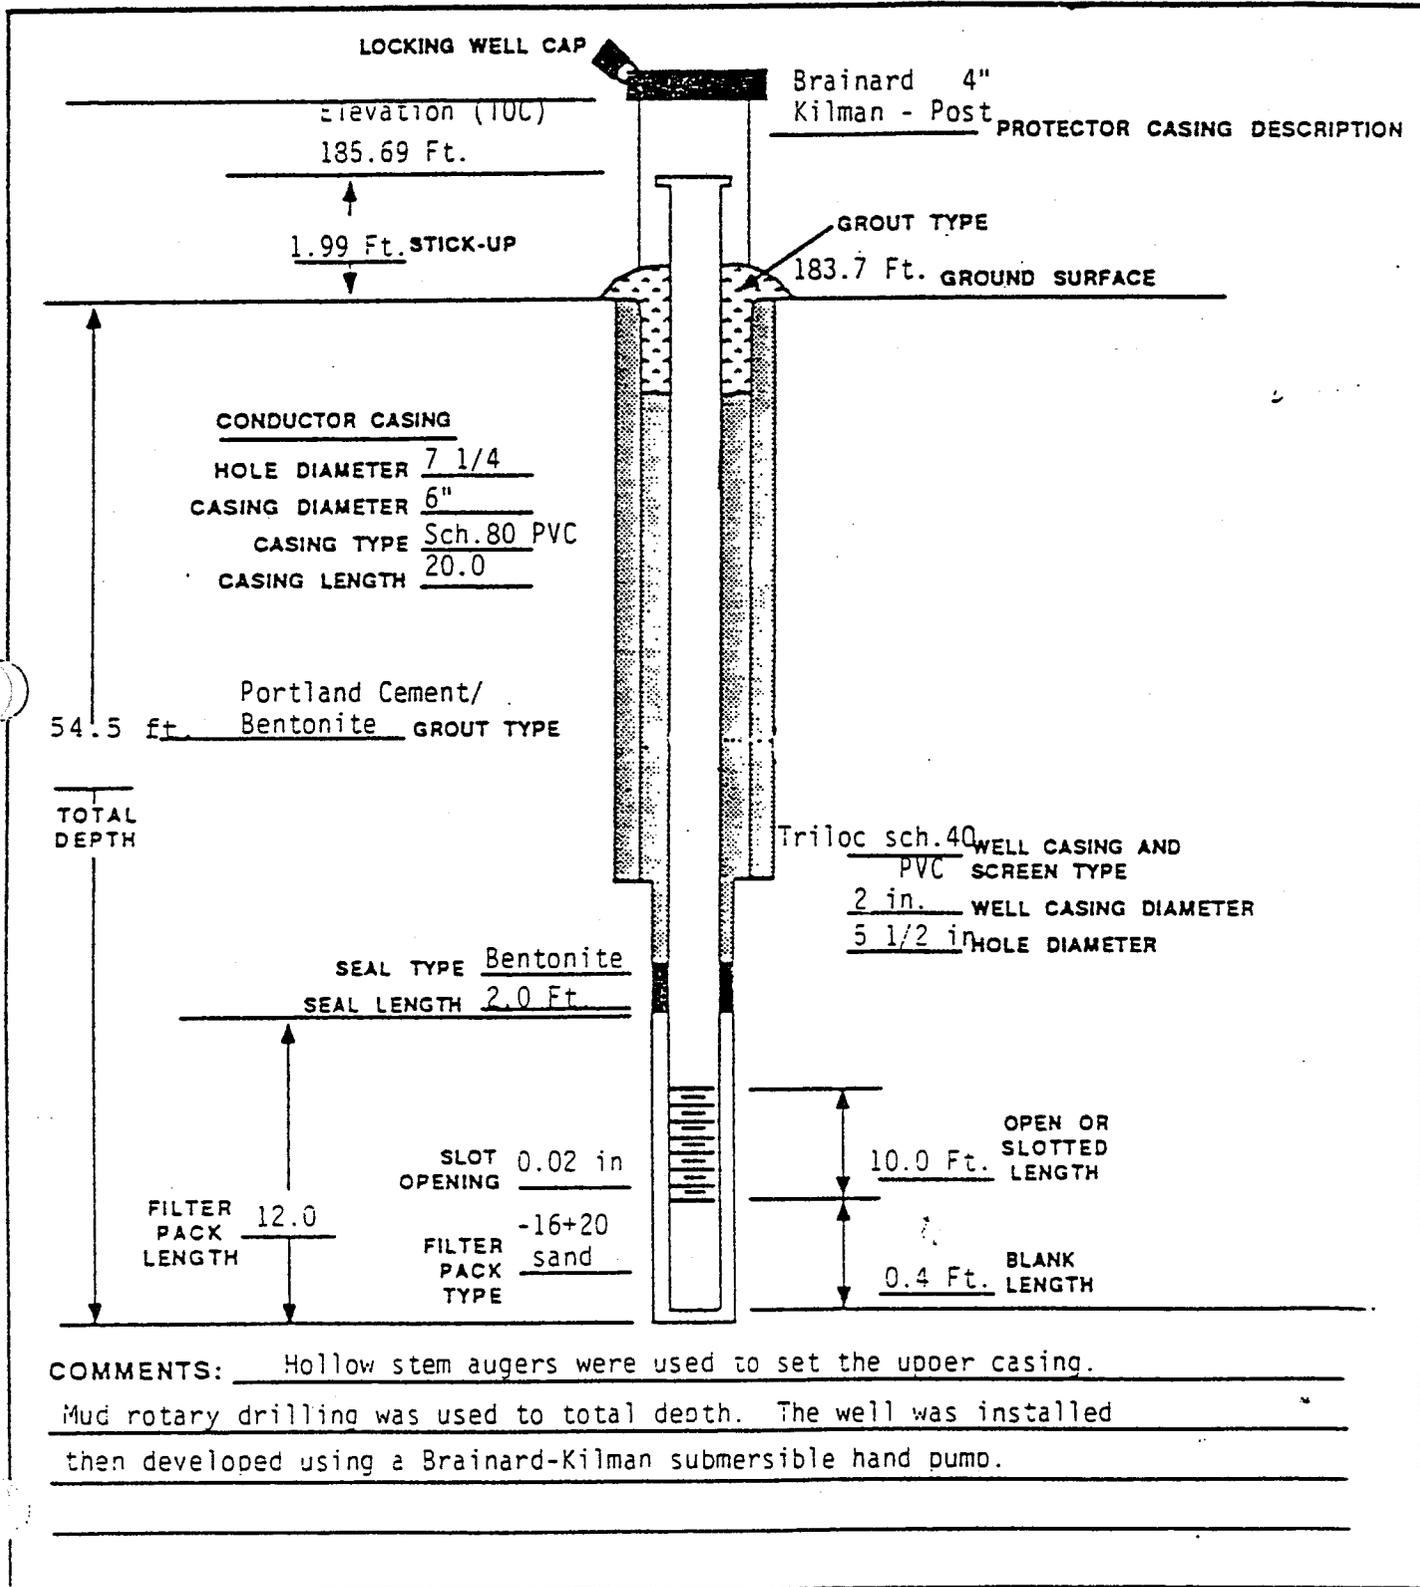

COMMENTS: Hollow stem augers were used to set the upper casing.
Mud rotary drilling was used to total depth. The well was installed
then developed using a Brainard-Kilman submersible hand pump.

WELL CONSTRUCTION DIAGRAM

PROJECT: Torrington Co.
 LOCATION: Sylvania, GA
 WELL NUMBER: W-27S ELEVATION: 183.7 Ft.
 DATE INSTALLED: April 15, 1988 GROUND CASING PROTECTOR CASING
 ABOVE GROUND LEVEL ABOVE MEAN SEA LEVEL

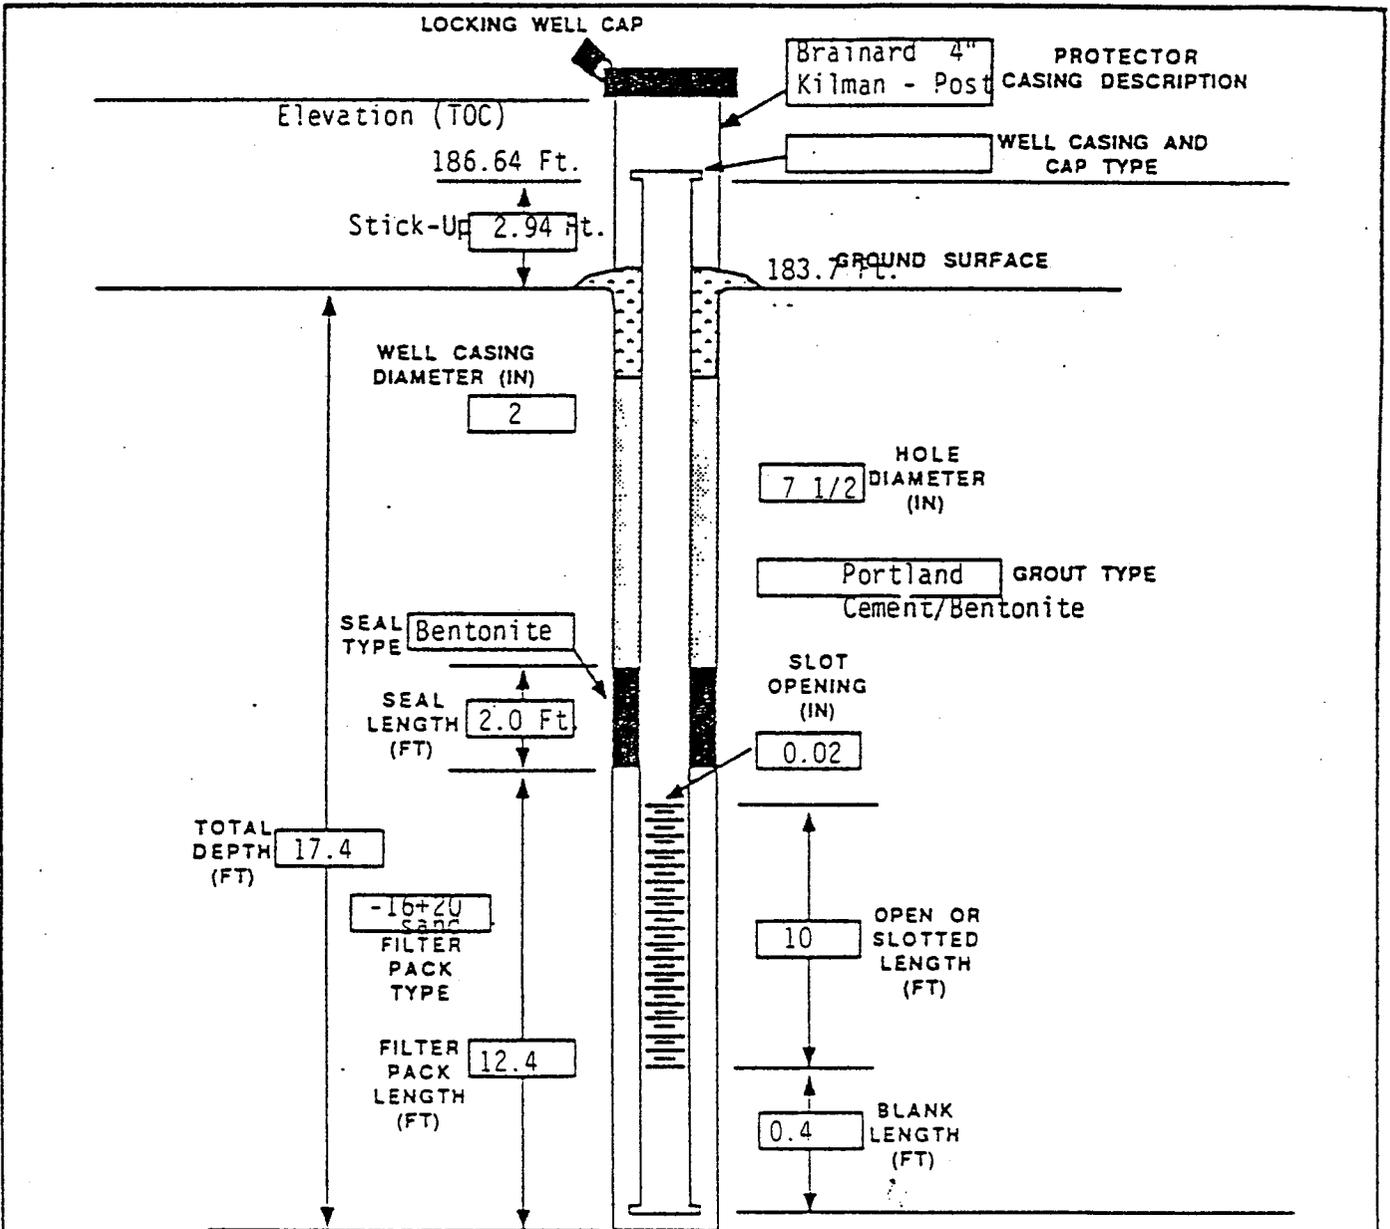


COMMENTS: The well was drilled using a hollow stem auger.
It was developed using a bailer.

WELL CONSTRUCTION DIAGRAM

PROJECT: Torrington Co.
 LOCATION: Sylvania, GA
 WELL NUMBER: W-285
 DATE INSTALLED: April 5, 1988


ELEVATION: 174.1 Ft.
 GROUND CASING PROTECTOR CASING
 ABOVE GROUND LEVEL ABOVE MEAN SEA LEVEL

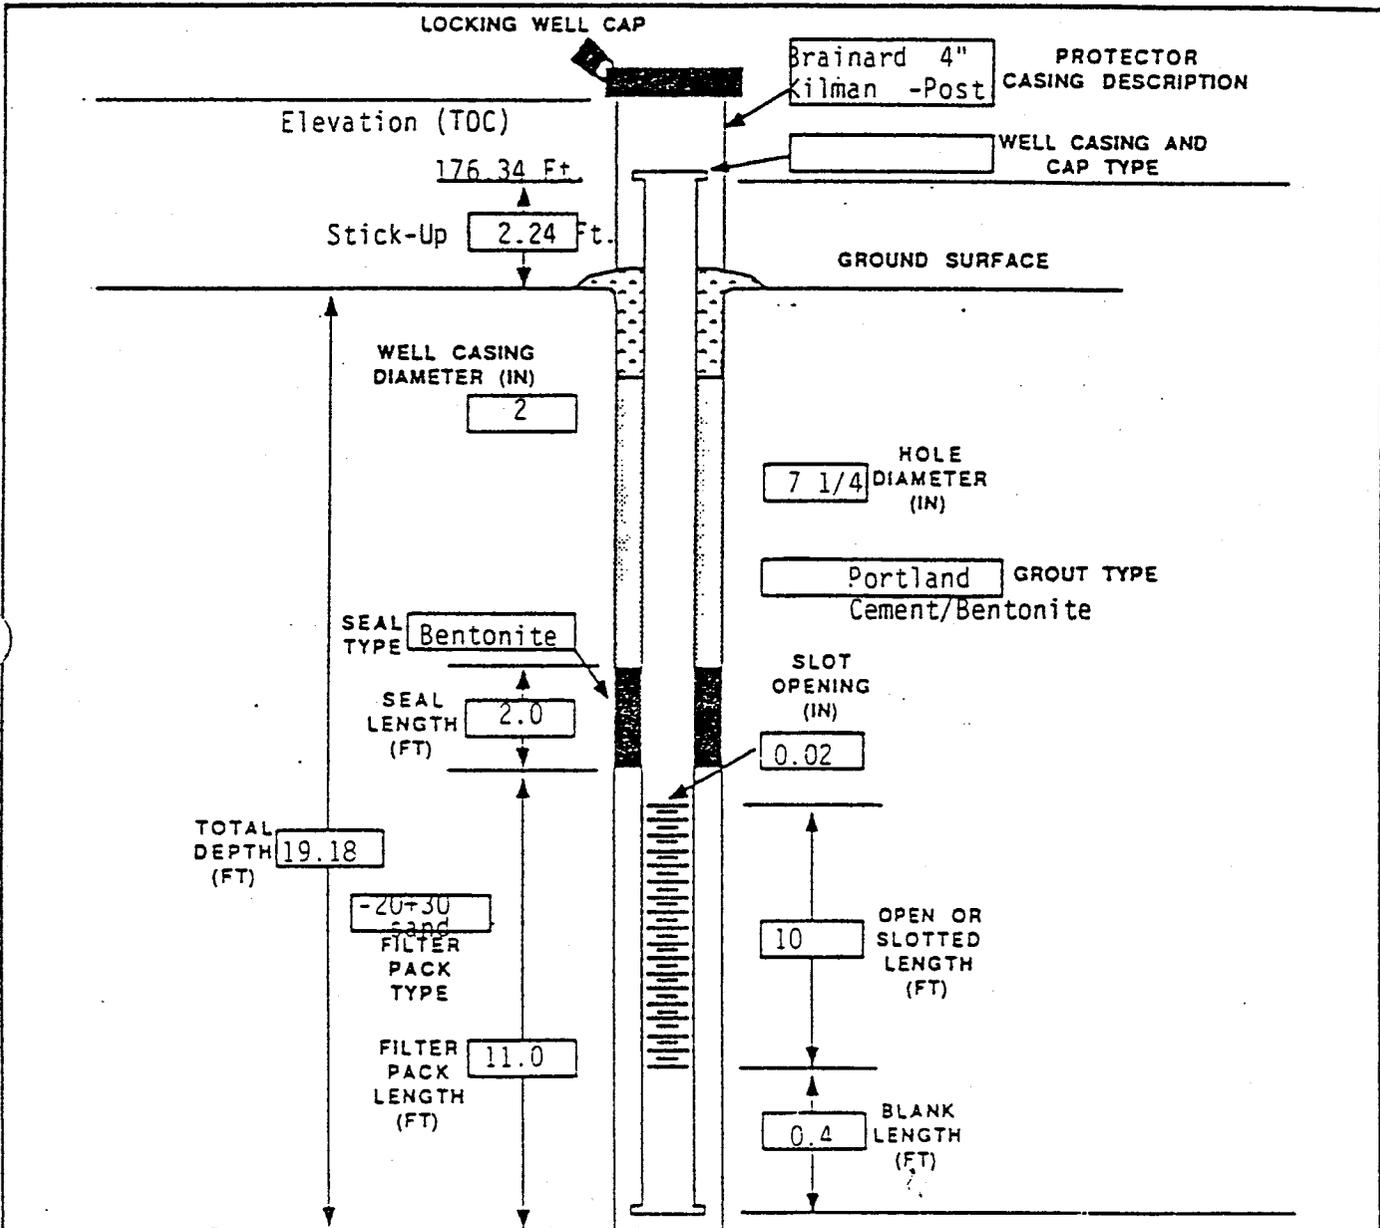

COMMENTS: The well was drilled using a hollow stem auger.
It was developed using a bailer.

WELL CONSTRUCTION DIAGRAM


PROJECT: TORRINGTON
 LOCATION: SYLVANIA, GA.
 WELL NUMBER: W-29 ELEVATION: 134.6 FT.
 DATE INSTALLED: April 20-21, 1988 GROUND CASING PROTECTOR CASING
 ABOVE GROUND LEVEL ABOVE MEAN SEA LEVEL

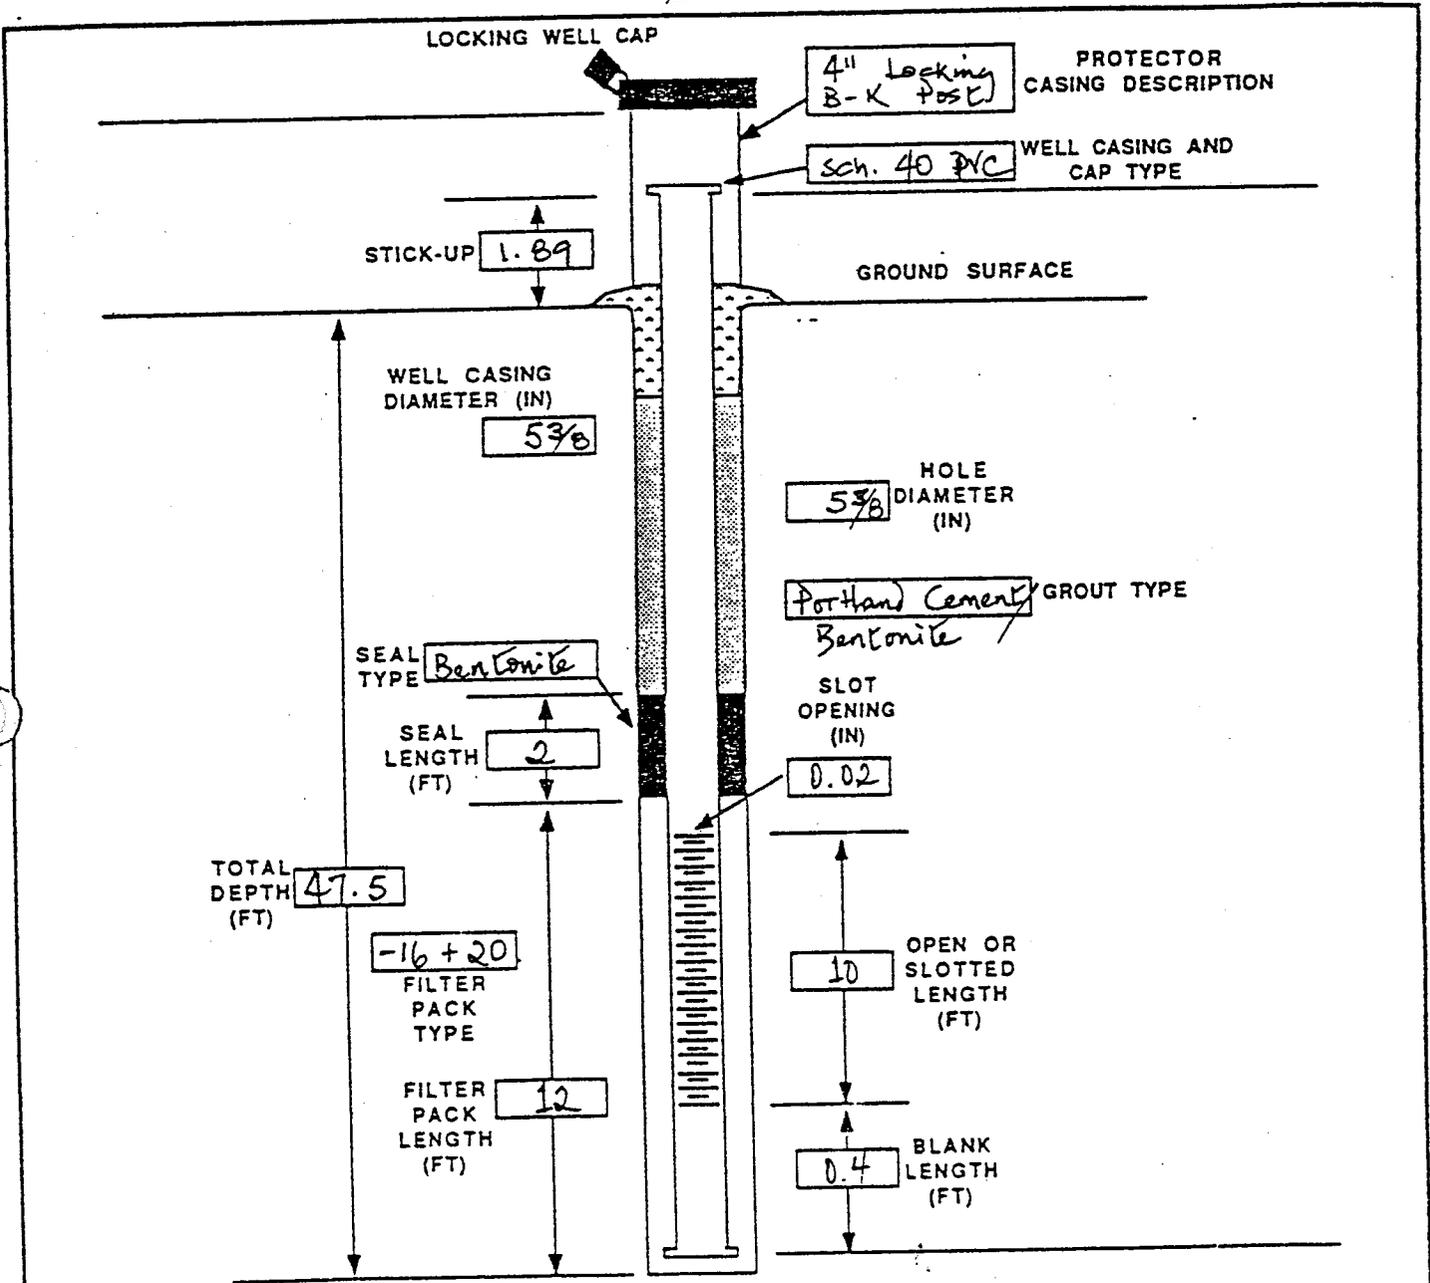

COMMENTS: _____

PROJECT: Torrington Company
 LOCATION: Sylvania, Georgia
 WELL NUMBER: W-30
 DATE INSTALLED: September 13, 1988

ELEVATION: _____
 GROUND CASING PROTECTOR CASING
 ABOVE GROUND LEVEL ABOVE MEAN SEA LEVEL

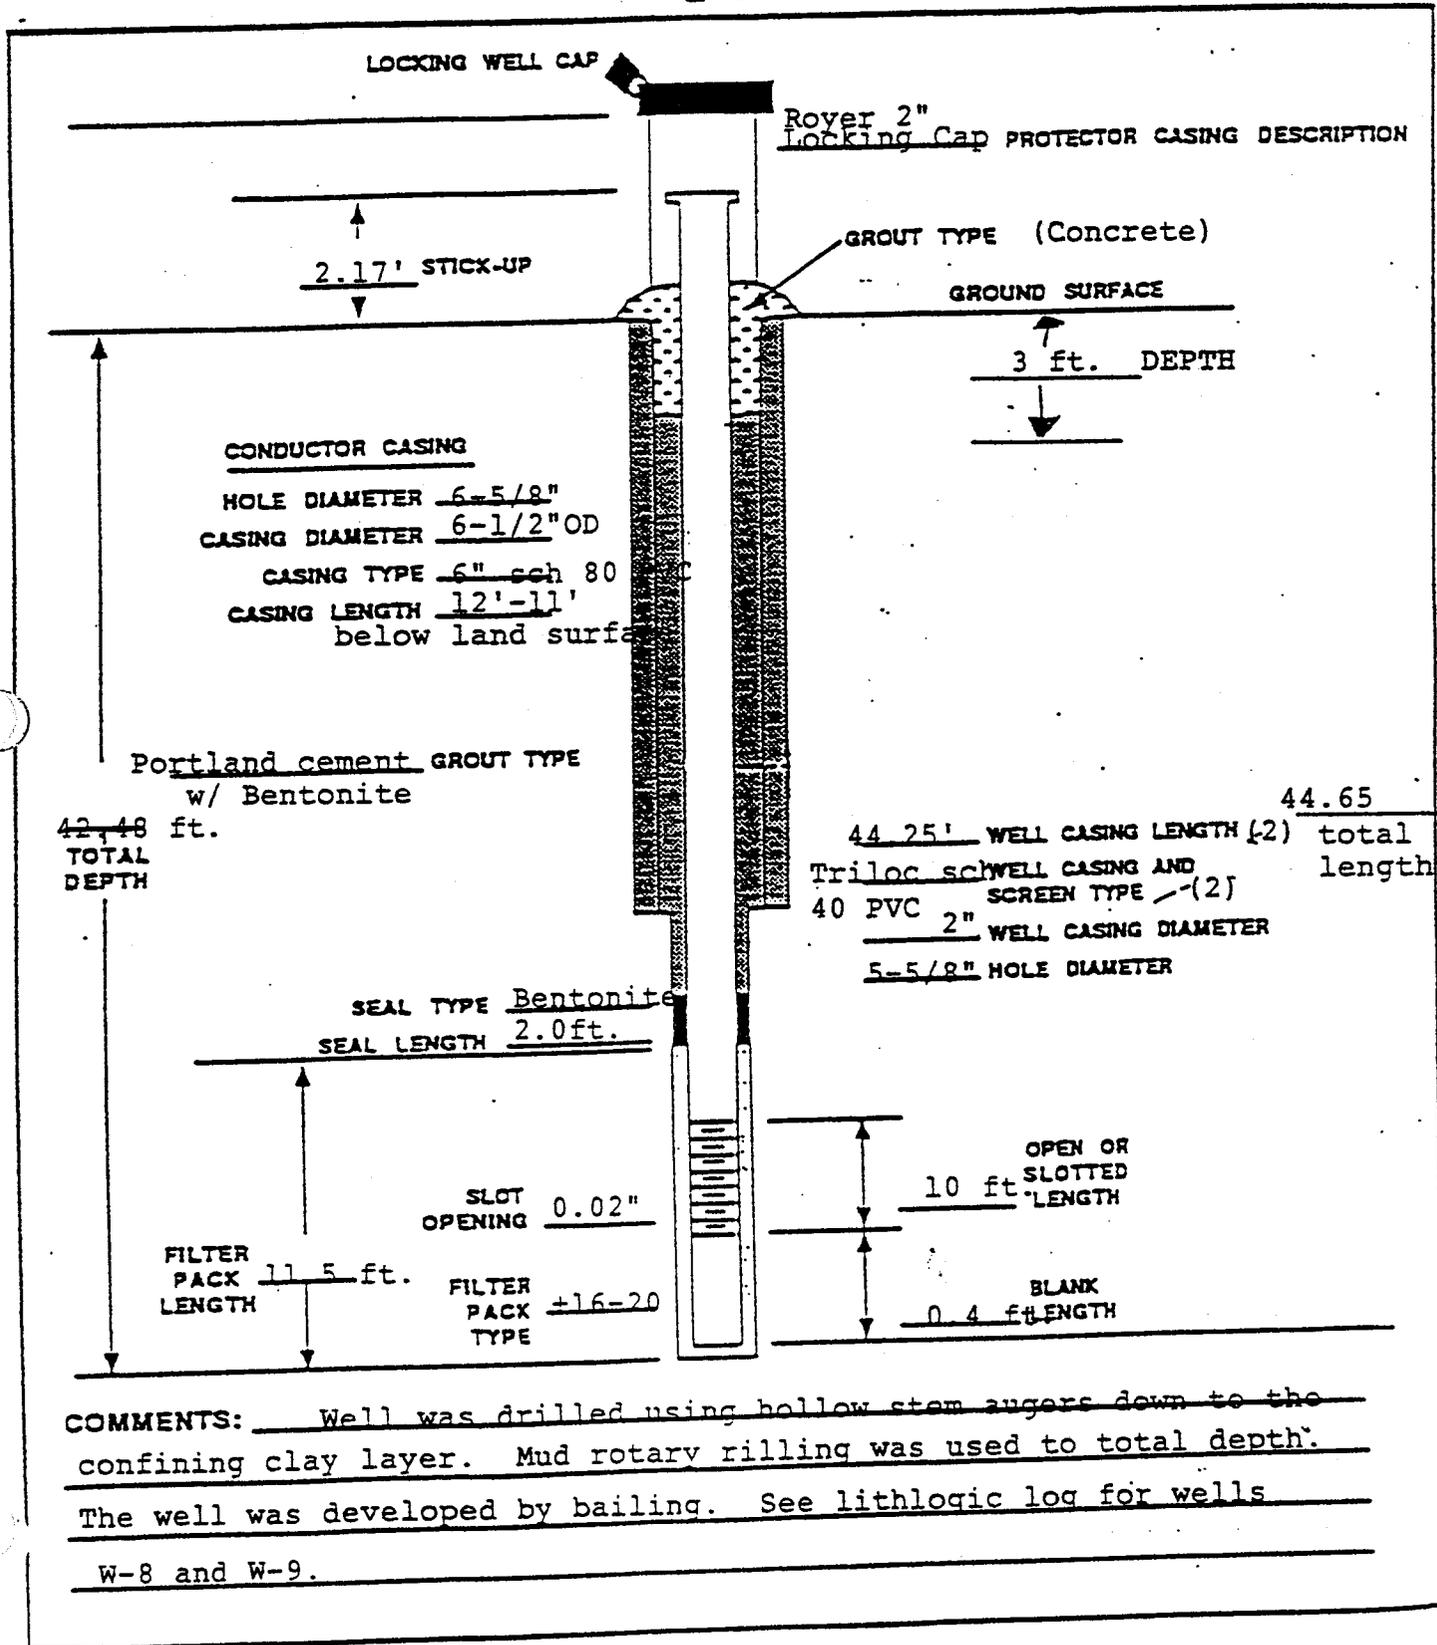


COMMENTS: Well was drilled using hollow stem augers down to the
confining clay layer. Mud rotary rilling was used to total depth.
The well was developed by bailing. See lithologic log for wells
W-8 and W-9.

WELL CONSTRUCTION DIAGRAM

PROJECT: Torrington/Sylvania
LOCATION: Well 15 Area
WELL NUMBER: LS-2
DATE INSTALLED: 5/31/89

ELEVATION: 2157.32
 GROUND CASING PROTECTOR CASING
 ABOVE GROUND LEVEL ABOVE MEAN SEA LEVEL

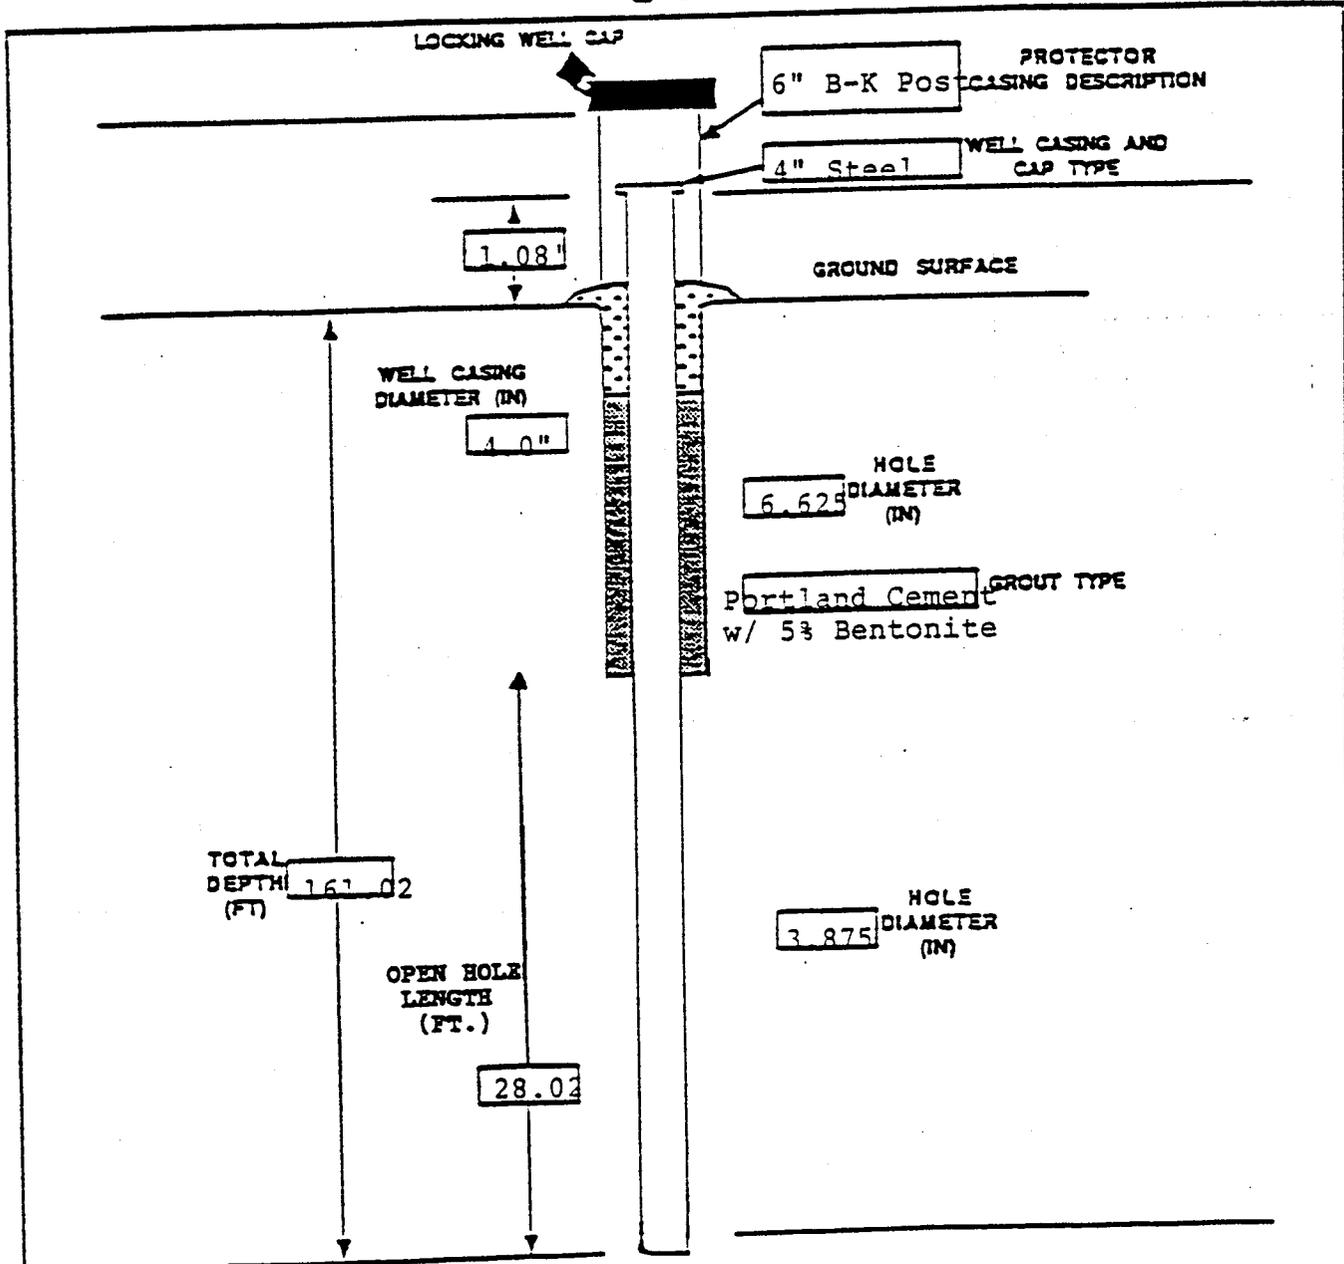

COMMENTS: Drilled to 112.0ft and lost returns. Ran 4" steel casing and drove casing to 133.0 ft. Drilled out with 2-7/8" bit to TD. Well was developed using an air compressor.

ATLANTA ENVIRONMENTAL MANAGEMENT, INC.

WELL CONSTRUCTION DIAGRAM

PROJECT: The Torrington Company


LOCATION: Sylvania, Georgia

WELL NUMBER: LS-3

GROUND ELEVATION (AMSL): _____

DATE INSTALLED: 5/4/94

CASING ELEVATION (AMSL): _____

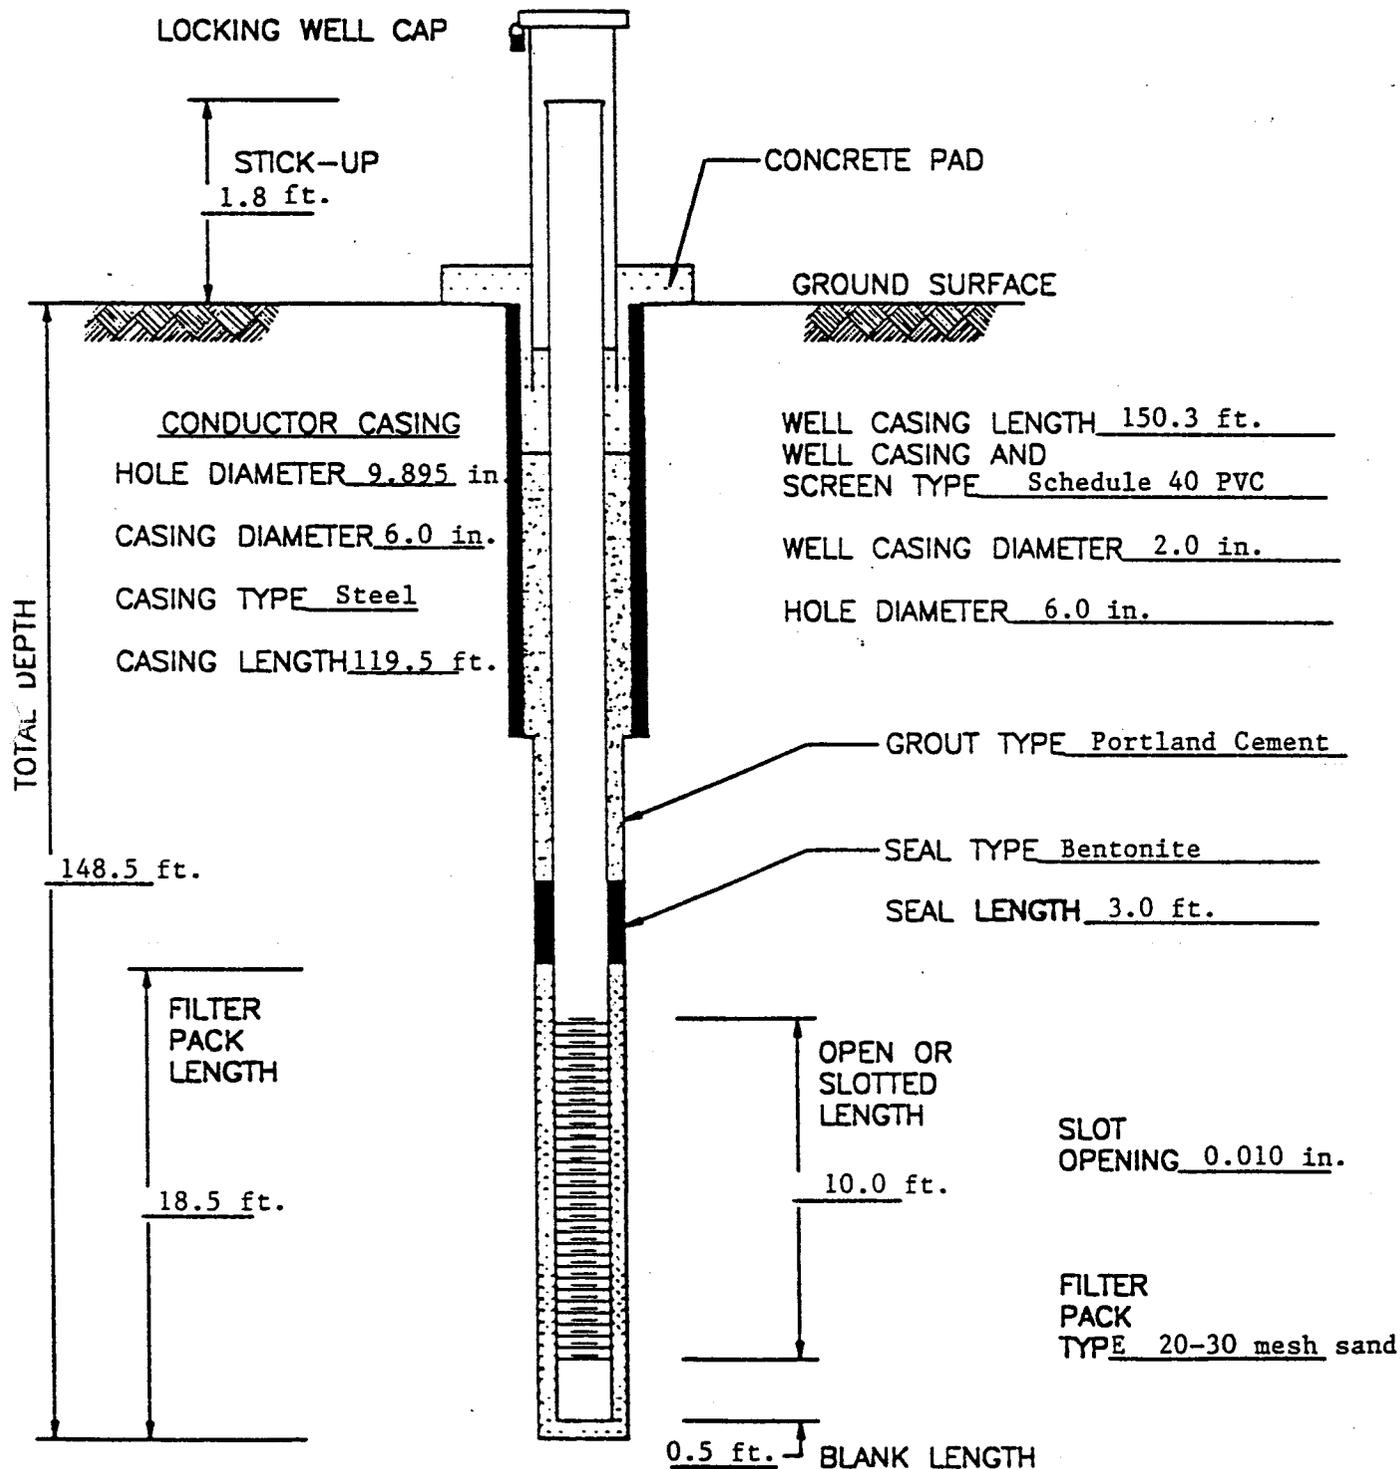

COMMENTS: A temporary 10-inch PVC casing was set to 19 feet prior to drilling borehole for conductor casing. Well was developed using a surge block and submersible pump.

DEPTH ELEVATION	SAMPLE NO	TYPE SAMPLE	SAMPLE DIST. RECOVERY	DESCRIPTION OF MATERIAL	UNIT DRY WT. LBS./FT. ³	UNCONFINED COMPRESSIVE STRENGTH (TONS/FT. ²)				
						1	2	3	4	5
						PLASTIC LIMIT %	WATER CONTENT %	LIQUID LIMIT %		
						SEANLAD N PENETRATION (BLDS-FT)				
						10	20	30	40	50

0.0				SURFACE ELEVATION 45-172.57 TDC-174.35						
1.0	1	SS		Light brown fine sand, trace silt - medium dense - moist - (SP)		15				
2.0	2	SS		White fine clayey sand, trace silt - medium dense - moist - (SC)		114				
3.0	3	SS				9				
4.0	4	SS				11				
5.0	5	SS		Multi-colored silty clay - stiff - moist - (CL)		12				
6.0	6	SS				19				
7.0	7	SS				17				
8.0	8	SS		Gray and brown fine sand, clay seams - medium dense - moist - (SP-SC)		7				
15.0						11				
25.0				White and gray fine to very fine sand - loose to medium dense - moist to wet - (SP)			23			
35.0										
45.0				End of boring at 46.0 feet.			27			

WATER LEVEL OBSERVATIONS		BORING STARTED 8/25/81	
WL Dry to EQB		BORING COMPLETED 8/25/81	
WL B.C.R.	A.C.R.	RIG CHE-45	FOREMAN
WL		DRAWN RJM	APPROVED RJK
		JOB # 92684	SHEET

STS CONSULTANTS, LTD.
 2400 ANNAPOLIS LANE
 BIRMINGHAM, MISSISSIPPI 38401

The stratification lines represent the approximate boundary between soil types and the transition may be gradual.

Atlanta Environmental Management Inc.
Monitoring Well Lithologic Log

Date: April 21-27, 1988

Owner: Torrington Co.
Well No: W-3D
Location: Adjacent to monitoring
Well W-3
Driller: Bob Stansfield
Geologist: Mark Potts
Drilling Method: Mud Rotary - 5 1/2"

Depth (feet)		Lithology	Remarks
From	To		
0	50	See Lithologic Log from wells W-8 and W-9 which are adjacent to this well.	
	60	Sandy clay - clayey sand (SC-CL)	Based on cuttings & drilling progress.
60	62.5	Clay Content decreasing (SC)	
62.5		Grayish white fine grained silty sand -well sorted, clay blebs up to 1/4" with iron staining (SM)	62.5-64 sample #1. 3-5-8
	97.5	Grayish white fine grained silty sand -well sorted with occasional clay blebs up to 1/8" in size (SM)	82.5-84. sample #2. 6-4-16
97.5	103	Top 3" gray fat clay. Middle 8" tan, fine grained poorly sorted silty sand. Bottom 6" fat gray clay. Rust stains. (SM-CH)	97.5 - 99. sample #3
103	113	Interbedded fine grained poorly sorted dark green silty sand within a fat gray clay unit 50% clay (CH). (CH)	
113		Tan, fine grained fossiliferous limestone with shell fragments.	
		TOTAL DEPTH: 113.5 FEET	
		Bottom of hole 0.5 feet into limestone. Sealed on the bottom with bentonite pellets to a depth of 105 feet -- sand above.	
		See the attached well construction diagram for well completion details.	

DRILLING LOG	COMPANY <i>Tarrington</i>	INSTALLATION <i>Sylvania Ga.</i>	SHEET OF 1 SHEETS
LOCATION (Coordinates or Station) <i>north corner of lagoon</i>	SIZE AND TYPE OF BIT <i>4" hand auger, 7 1/4" & 4 5/8" fish tail</i>		
DRILLING AGENCY <i>Geothermics</i>	TOTAL NO. OF OVERBURDEN SAMPLES TAKEN <i>2 split spoon</i>		
THICKNESS OF OVERBURDEN <i>NA</i>	DATE HOLE <i>18 June 85</i>	COMPLETED <i>19 June 85</i>	
DEPTH DRILLED INTO ROCK <i>NA</i>	ELEVATION TOP OF HOLE <i>171.47 msl</i>		
TOTAL DEPTH OF HOLE <i>40.5'</i>	ELEVATION GROUND WATER		
NAME OF DRILLER <i>Paul N. Clawson</i>	SIGNATURE OF INSPECTOR OR GEOLOGIST <i>Paul F. Titcomb Jr</i>		

ELEVATION	DEPTH	LEGEND	CLASSIFICATION OF MATERIALS (Description)	SPT	BOX OR SAMPLE NO.	REMARKS (Drilling time, water loss, depth of weathering, etc., if significant)
			SM brown silty sand turns yellow-orange 1.5'			0 to 8.0' hand augered with 4" auger, 16 June.
<i>WL 4.75</i> <i>16 June</i>	5		SC orange-yellow clayey sand. Becomes mottled gray orange 4.5' very clayey 7.0' -			
	10		CH maroon & gray plastic clay, some orange silt & sand - 9		1	
	15					
	20		more orange silty clay			
	25					
	30		becomes sandy gradational contact			
	35		SC gray to tan fine clayey sand			
	35		zone coarse sand	35	2	
	40		hole completed 40.5'			

NOTE: Soils field classified in accordance with the Unified Soil Classification Systems.

DRILLING LOG	COMPANY <i>Tarrington Industries</i>	INSTALLATION <i>Sylvania</i>	SHEET OF 1 SHEETS
LOCATION (Coordinates or Region) <i>20.5E corner of lagoon</i>	SIZE AND TYPE OF BIT <i>4" Hand Auger, 7 1/4" & 4 5/8" Ashitail</i>		
DRILLING AGENCY <i>Geothermics</i>	TOTAL NO. OF OVERBURDEN SAMPLES TAKEN <i>2 splitspoon</i>		
THICKNESS OF OVERBURDEN <i>NA</i>	DATE MOLE	STARTED <i>15 June 85</i>	COMPLETED <i>18 June 85</i>
DEPTH DRILLED INTO ROCK <i>NA</i>	ELEVATION TOP OF HOLE <i>172.17 msl</i>		
TOTAL DEPTH OF HOLE <i>44.0'</i>	ELEVATION GROUND WATER		
NAME OF DRILLER <i>Paul Clawson</i>	SIGNATURE OF INSPECTOR OR GEOLOGIST <i>Carl F. Telesco</i>		

ELEVATION	DEPTH	LEGEND	CLASSIFICATION OF MATERIALS (Description)	SPT	BOX OR SAMPLE NO.	REMARKS (Drilling time, water loss, depth of weathering, etc., if significant)
	0		SM tan silty sand			0 to 12.0' hand augered adjacent to MW9
	5		SC orange clayey sand			
<i>WL 7.1</i> <i>15 June</i>	10		CL orange and gray sandy clay			Hole reamed to 11.5' with 7 1/4" reamer. Placed 12.6' of 6" Sch 80 casing. Drove into clay with 140lb hammer approx. half foot
	15		CH maroon & gray plastic clay	-15	1	
	20		pale olive green			
	25					Reamed hole with 4 5/8" bit to 44.0'
	30		gradational contact			
	35		SC yellow-tan clayey sand fine to med. grained Much clay, occasional fine quartz gravel	-20	2	
	40		Hole completed to 44.0'			

NOTE: Soils field classified in accordance with the Unified Soil Classification Systems.

Atlanta Environmental Management Inc.
Monitoring Well Log

Date: July 26-27, 1987

Owner: TORRENTON CO. Screened From: _____ ft. to _____ ft.
 Well No: W-15 Gravel Pack: _____ mesh to _____ ft.
 Location: Northernmost Property Bentonite Seal: _____ ft. to _____ ft.
Boundary Well. Concrete Seal from _____ ft. to surface
 Driller: Paul Clawson, Geotechnical Water Level: _____ ft. below well top.
 Geologist: M. Potts Well top elevation: _____ ft.
 Drilling Method: HSA to $\approx 15'$
5 1/4" Drag Bit - Mud Rotary
to Total Depth

Depth (feet) From	To	Lithology	Remarks
0		yellowish brown silty fine grained, mod. well sorted sand	Sample #1 (SM) 4-5 1/2 ft. 2-2-4
9 1/2		SAME	Sample #2 (SM) 8 1/2 - 10 ft. 6-6-9
9 1/2	13	Grayish white clayey fine sand $\approx 30\%$ clay. yellow & red mottling (SC)	Sample #3
13		Light olive gray fat clay with purple and yellow mottling (C4)	13.5 - 15 ft. 3-5-8
		gray fat clay with thin laminations (C4-2mm) of SC	Sample #4 (C4-CL) 18.5 - 20 ft. 6-11-15
	27.5	SAME. less sand	Sample #5 (C4) 23.5 - 25 ft. 6-9-7
27.5		Change in drilling. silty fine sand. mod. well sorted.	Sample #6 (SM) 28.5 - 30 ft. 3-5-7
		Grayish white fine grained well sorted quartz sand, minor silt. thin vertical laminations of clay (SM) within sands 1-2 mm.	Sample #7 40.5 - 42 ft. 5-15-21
		Total depth 42 feet. Below confining clay; total depth reached.	

Atlanta Environmental Management Inc.
Monitoring Well Log


Date: 3/21/89

Owner: <u>Torrington/Sylvania</u>	Screened From: <u>105.3</u> ft. to <u>115.3</u> ft.
Well No: <u>W-15D</u>	Gravel Pack: <u>30-40</u> mesh to <u>103.0</u> ft.
Location: <u>Adjacent to W-31</u>	Bentonite Seal: <u>101.0</u> ft. to <u>103.0</u> ft.
<u>and W-15</u>	Concrete Seal from <u>101.0</u> ft. to surface
Driller: <u>Middle Georgia</u>	Water Level: <u>26.0</u> ft. below well top.
Geologist: <u>Ron Yarborough</u>	Well top elevation: _____ ft.
Drilling Method: <u>Mud Rotary</u>	

Depth (feet) From	To	Lithology	Remarks
65.0	66.5	SC - Tan, Orange, very fine to fine grained, loosely to unconsolidated, sub rounded-rounded, moderately sorted.	Drilled to 76' Set 6" casing - Had to wash casing down
	81.5	CL - Light green, light gray, soft, very sandy with streaks of light orange sand.	5-5/8" Well Bore
81.5	81.5		
	89.0		
89.0	91.5	SC - Light green, tan, orange, very fine grained, loosely consolidated, well sorted. Abundant clay Matrix	
	101.5	SC - Light orange, light gray, tan, very fine grained, loosely consolidated, sub rounded - rounded with abundant clay Matrix	
	116.0		
116.0	117.0	CL - Dark red, dark gray, white soft to moderately firm, trace sand	Set 2" PVC Sch 40
117.0	117.5	LS - Buff, tan, soft, fossiliferous limestone	At 115.7
Well was terminated when limestone was reached. Sufficient depth for characterization. Lost circulation and was unable to get 2" casing in hole. Had to wash down 4" steel casing and run 2" PVC through 4" and pull 4" casing out of hole.			

JOB NUMBER: _____

PROJECT: TORRINGTON
 LOCATION: SYLVANIA GA
 BOREHOLE NUMBER: N-17
 DATE DRILLED: 7-24-87
 FIELD REPRESENTATIVE: MARK POTTS
 DRILLING CONTRACTOR: Geothermics
 DRILLER: Paul Clawson
 DRILLING METHOD: Horizontal Stem Auger
 HOLE DIAMETER: 6 1/2"
 GROUND ELEVATION: 156.0 ft.
 CONDITION OF GROUND SURFACE: _____

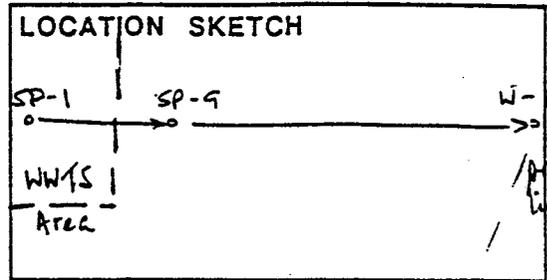

COMMENTS: _____

DEPTH	SAMPLE					SAMPLE DESCRIPTION
	NUMBER	INTERVAL AND TYPE	ADVANCED/RECOVERED	BLOW COUNTS PER 6 INCHES	WATER TABLE	
0						
5	1			3		Yellowish brown fine grained clayey sand. moderately well sorted.
10	2			4		Yellowish brown fine grained clayey sand moderately poorly sorted. ≈ 50/50 SC-CL sands / silts + clays
15	3			5		Orange brown clayey fine grained sand, less clay & silts than at 9', ≈ 25% fines. Soil salting up on the augers.
20	4			8		- Easter Drilling at 16'. Orange brown clayey fine grained sand, similar to above. moderately well sorted.
25	5					to 23.5 ft.

Mark A. Potts
 GEOLOGIST'S SIGNATURE

Atlanta Environmental Management Inc.
Monitoring Well Log

Date: 3-2-89

Owner: <u>Torrington/Sylvania</u>	Screened From: <u>56.34</u> ft. to <u>66.34</u> ft.
Well No: <u>17D</u>	Gravel Pack: <u>30-40</u> mesh to <u>53.3</u> ft.
Location: <u>Adjacent to W-17 on property boundary</u>	Bentonite Seal: <u>52.0</u> ft. to <u>53.3</u> ft.
Driller: <u>Paul Clawson</u>	Concrete Seal from <u>52.0</u> ft. to surface
Geologist: <u>Ron Yarborough</u>	Water Level: <u>29.65</u> below well top.
Drilling Method: <u>Mud Rotary</u>	Well top elevation: _____ ft.

Depth (feet)		Lithology	Remarks
From	To		
0	10.0'	SC - Sandy clay, drillers notes	
10.0'	17.0	CL - Tough clay, drillers notes	8-1/2" Wellbore
17.0	40.0	SC - Clayey sand, drillers notes	
	41.5	SC - Sand light gray, clear, very fine to fine grained unconsolidated to loosely consolidated sand with clayey Matrix sub angular - Angular	Sample #1 40.0 - 41.5
	46.5	SC - Sand light gray, clear, very fine grained, loosely consolidated to unconsolidated. Angular to sub angular quartz	Set 6" casing at 50'
	51.5	SC - Sand light gray, clear, very fine grained, grading to silt well Sorted	5-5/8" Wellbore
	56.5	SC - Clayey sand, light gray, clear, very fine grained, well sorted with clay Matrix	
	61.5	SC - Clayey sand, clear, light gray, light green, very fine grained, well sorted with clay Matrix	
65.0	66.5	CL - Sandy clay, light gray, orange, laminated clay and sand	Set 2" PVC Sch 40 at 68.33'
70.0	71.5	CL - As above	

Well terminated at 70'-Sufficient depth for intermediate investigation.

Atlanta Environmental Management Inc.
Monitoring Well Lithologic Log

Date: March 29-April 1, 1988

Owner: Torrington Co.
Well No: W-19
Location: Offsite. NE of
softball field
Driller: Bob Stansfield
Geologist: Mark Potts
Drilling Method: Mud Rotary - 5 1/2"

Depth (feet)		Lithology	Remarks
From	To		
0		Grayish white poorly sorted fine to med. grained clayey sand, up to 40% clay.	5-6.5 ft. Sample #1.
		Reddish brown mottling. (SC)	6-12-17
		Grayish white poorly sorted fine to med. grained clayey sand, up to 40% clay.	8.5-10 ft. Sample #2.
		Reddish brown mottling. (SC)	4-8-12
17		Orange brown poorly sorted fine grained clayey sand. Up to 20% fines	13.5-15 ft. Sample #3
		Gradational contact. (SC)	6-9-12
17		Yellowish-brown silty fine sand, well sorted w/up to 30% fines. (SM)	18.5-20 ft. Sample #4.
			5-6-9
		Yellowish-brown silty fine sand, well sorted w/up to 30% fines. (SM)	23.5-25 ft. Sample #5.
			3-5-7
33		Yellowish brown silty fine sand, well sorted w/up to 30% fines. (SM)	28.5-30 ft. Sample #6.
			2-3-5
33		Yellowish brown clayey fine sand. 20-30% fines. (SC)	33.5-35 ft. Sample #7.
			2-3-5
47		Yellowish brown clayey fine sand. <3% black staining - manganese (?) (SC)	38.5-40 ft. Sample #8.
			2-4-7
47		Yellowish brown silty fine sand, 20-30% fines, rust staining (10%) (SM)	48.5-50 ft. Sample #9.
			2-4-6
		Alternating bands of gray silty sand with greenish gray fat clay (up to 1" thick). (SM-CH)	58.5-60 ft. Sample #10.
			2-4-7
		Gray silty fine sand, up to 20% silt, manganese staining, several x, and some rust staining (5%) (SM)	68.5-70 ft. Sample #11.
			6-17-14
		Yellowish brown silty fine sand with clay blebs up to 1-2" intermixed. 10% rust staining on bedding. 30% clay overall (SM-CH)	78.5-80 ft. Sample #12.
			3-12-14
		Hole terminated at 80 feet due to sufficient characterization at this location.	

Atlanta Environmental Management Inc.
Monitoring Well Lithologic Log

Date: March 20-22, 1988

Owner: Torrington Co.
Well No: W-21
Location: offsite
Driller: Bob Stansfield
Geologist: Mark Potts
Drilling Method: Mud Rotary

Depth (feet)		Lithology	Remarks
From	To		
0		Grayish white silty fine sand. Poorly sorted. (SM)	Sample #1. 3.5-5.0 ft. 3-9-14
		Grayish white clayey fine sand. Poorly sorted. (SC)	Sample #2. 10-11.5 ft. 3-4-9
	18	Grayish white poorly sorted clayey fine sand with goethite (iron) staining. (SC)	Sample #3. 15-16.5 ft. 3-9-13
18	21	Stiff greenish gray fat clay - <2% silt. (CH)	Sample #4. 20-21.5 ft. 2-4-9
		Yellowish brown poorly sorted clayey sand. (SC)	- H ₂ O producer. Sample #5. 25-26.5 ft. 2-2-2
21	25.5		
25.5	31	Stiff light greenish gray fat clay. (CH)	
31		Yellowish brown silty fine to medium grain sand. Poorly sorted. (SM)	Caving @ 35' - No Sample.
		Whitish gray silty fine to medium sand. (SM)	36-38.5 No blow count
		Drilling same.	No Sample. 40-41.5 ft.
	45	Drilling same. (SC-SM)	
45		50' Increase in clay content - SC \approx 20% clay. (SC)	50'
		60' Whitish gray poorly sorted clayey fine sand. (SC)	60' Sample off bottom of auger.
		70' Whitish gray poorly sorted clayey fine to medium sand. (SC)	70' Cuttings examined.
		80' Same as above. (SC)	80' Cuttings.
		86' Increase in clay content to \approx 30% clay. (SC)	
		Total Depth 86'. Sufficient characterization.	

Atlanta Environmental Management Inc.
Monitoring Well Lithologic Log

Date: 26-28 March, 1988

Owner: Torrington Co.
Well No: W-28
Location: SW of softball field,
near parking area
Driller: Paul Clawson
(Geothermics, Inc)
Geologist: Mark Potts
Drilling Method: Mud Rotary - 5 1/2"

Depth (feet)		Lithology	Remarks
From	To		
0	5 1/2	Orangish brown clayey medium to fine sand, 20-30% fines. 4-5 feet - clean coarse sand, well sorted. (SC)	4-5 1/2. Sample #1. 11-20-24
5 1/2	9	Orange and yellowish brown sandy clay - clayey sand (CL-SC)	Very slow drilling 5 1/2-9'
9		Grayish white clayey medium to coarse sand (10-20% clay) with red and orange mottling. (SC)	9-10 1/2. Sample #2. 4-6-6
	15 1/2	Grayish white clayey medium to coarse sand (10-20% clay) with red and orange mottling. (SC)	14-15 1/2. Sample #3. 4-5-6
15 1/2	19	Reddish to orange brown sandy clay. Sand very fine to medium. (CL)	
19	21 1/2	Greenish gray, clayey fine to medium sand. Very poorly sorted with some coarse sand. Set 6" casing to 19.3 ft (SC)	19-20 1/2. Sample #4. 3-7-10
21 1/2	22 1/2	Clean medium to coarse sand (SW)	
22 1/4	28.1	Very tough, gray sandy clay with up to 15-20% sand as clayey sand lenses (CL)	25-26.5. Sample #5. 7-17-26
28.1	29.4	Very hard, iron-cemented fine grained sandstone	Drilling cuttings examined.
29.4		Very hard, greenish gray clayey sand-sandy clay. Dry, very poorly sorted medium to fine grained sand (SC-CL)	30-31.5. Sample #6. 20-27-42
	36.7	Gray, very hard, dry clayey fine to medium sand. (SC)	35-36.5. Sample #7. 6-13-30
36.7	37.8	Very hard, cemented fine sandstone.	Drilling cuttings examined.
37.8		Gray clayey fine to medium sand. Very poorly sorted w/20% fines (SC)	40-41.5. Sample #8. 3-9-13
		Gray clayey fine to medium sand. Very poorly sorted w/20% fines (SC)	45-46.5. Sample #9. 4-8-10

Atlanta Environmental Management Inc.
Monitoring Well Lithologic Log

Date: April 20-21, 1988

Owner: Torrington Co.
Well No: W-29
Location: Offsite

Driller: Paul Clawson
(Geothermics, Inc)
Geologist: Mark Potts
Drilling Method: Mud Rotary - 5 1/2"

Depth (feet)		Lithology	Remarks
From	To		
0	8	Yellowish brown fine to medium sand. (SW)	4-5 1/2. Sample 1. 2-6-11
8		Reddish brown clayey fine sand w/ 15-30% clay (SC)	9-10 1/2. Sample 2. 8-19-16
		Reddish brown medium grain clayey sand. 15-30% clay (SC)	14-15 1/2. Sample 3. 21-42-
	22	Reddish brown medium grain clayey sand. 15-30% clay (SC)	14-15 1/2. Sample 4. 18-27
22	24.7	Coarse sand with a trace to several % clay (SW)	24-25.5. Sample 5. Cuttings examined
24.7		Yellowish brown clayey fine to medium sand w/20% clay (SC)	29-30.5. Sample 6. 13-14-15
		Yellowish brown clayey fine to medium sand w/20% clay (SC)	34-35.5. Sample 7. 8-12-12
	49.5	Yellowish brown clayey fine to medium sand w/20% clay (SC)	39-35.5. Sample 7. 8-12-14
49.5	53	Tan clayey fine to medium grained sand (40-50% clay) (SC)	49-50.5. Sample 9. 6-5-6
53		Yellowish brown clayey fine to medium sand, poorly sorted w/20% clay (SC)	59-60.5. Sample 10. 10-14-13
	70.5	Yellowish brown clayey fine to medium grained sand. Poorly sorted w/20% (SC)	69-70.5. Sample 11. 9-17-15
		Hole was terminated since a sufficient depth had been reached for characterization purposes at 70.5 feet.	

Atlanta Environmental Management Inc.
Monitoring Well Log

Date: 5/3-1989

Owner:	<u>Torrington/Sylvania</u>	Screened From:	<u>NA</u> ft. to <u>NA</u> ft.
Well No:	<u>LS-2</u>	Gravel Pack:	<u>NA</u> mesh to <u>NA</u> ft.
Location:	<u>W-15 Area-Along property boundary</u>	Bentonite Seal:	<u>NA</u> ft. to <u>NA</u> ft.
Driller:	<u>Charles Hill</u>	Concrete Seal from:	<u>33.0</u> ft. to surface
Geologist:	<u>Ron Yarborough</u>	Water Level:	<u>43.8</u> ft. below well top.
Drilling Method:	<u>Mud Rotary</u>	Well top elevation:	<u>150.32</u> ft.

Depth (feet) From	To	Lithology	Remarks
0.0	117.5	See Well log for W-15D	
117.5		LS- Buff-tan, trace light	Lost drilling mud
	135.0	Medium gray, hard, very weathered fossiliferous	returns at 112.0 only sporadic returns
140.0		Light gray, buff-hard fossili- ferous with trace light gray hard dense	Sample #1 135.0-140.0'
	145.0	Micro crystalline limestone	Sample #2 140.0-145.0'
	150.0	LS-Tan, buff, hard	Sample #3 145.0-150.0'
	155.0	Fossiliferous with a trace of	Sample #4 150.0-155.0'
	160.0	light gray dense, hard	Sample #5 155.0-160.0'
	162.0	micro crystalline limestone	Sample #6 160.0-165.0'

UST AREA

WELL CONSTRUCTION DIAGRAM

PROJECT: Torrington/Sylvania


LOCATION: Offset adjacent to fence

WELL NUMBER: W-R3

DATE INSTALLED: 3/3/89

ELEVATION: _____

GROUND CASING PROTECTOR CASING
 ABOVE GROUND LEVEL ABOVE MEAN SEA LEVEL

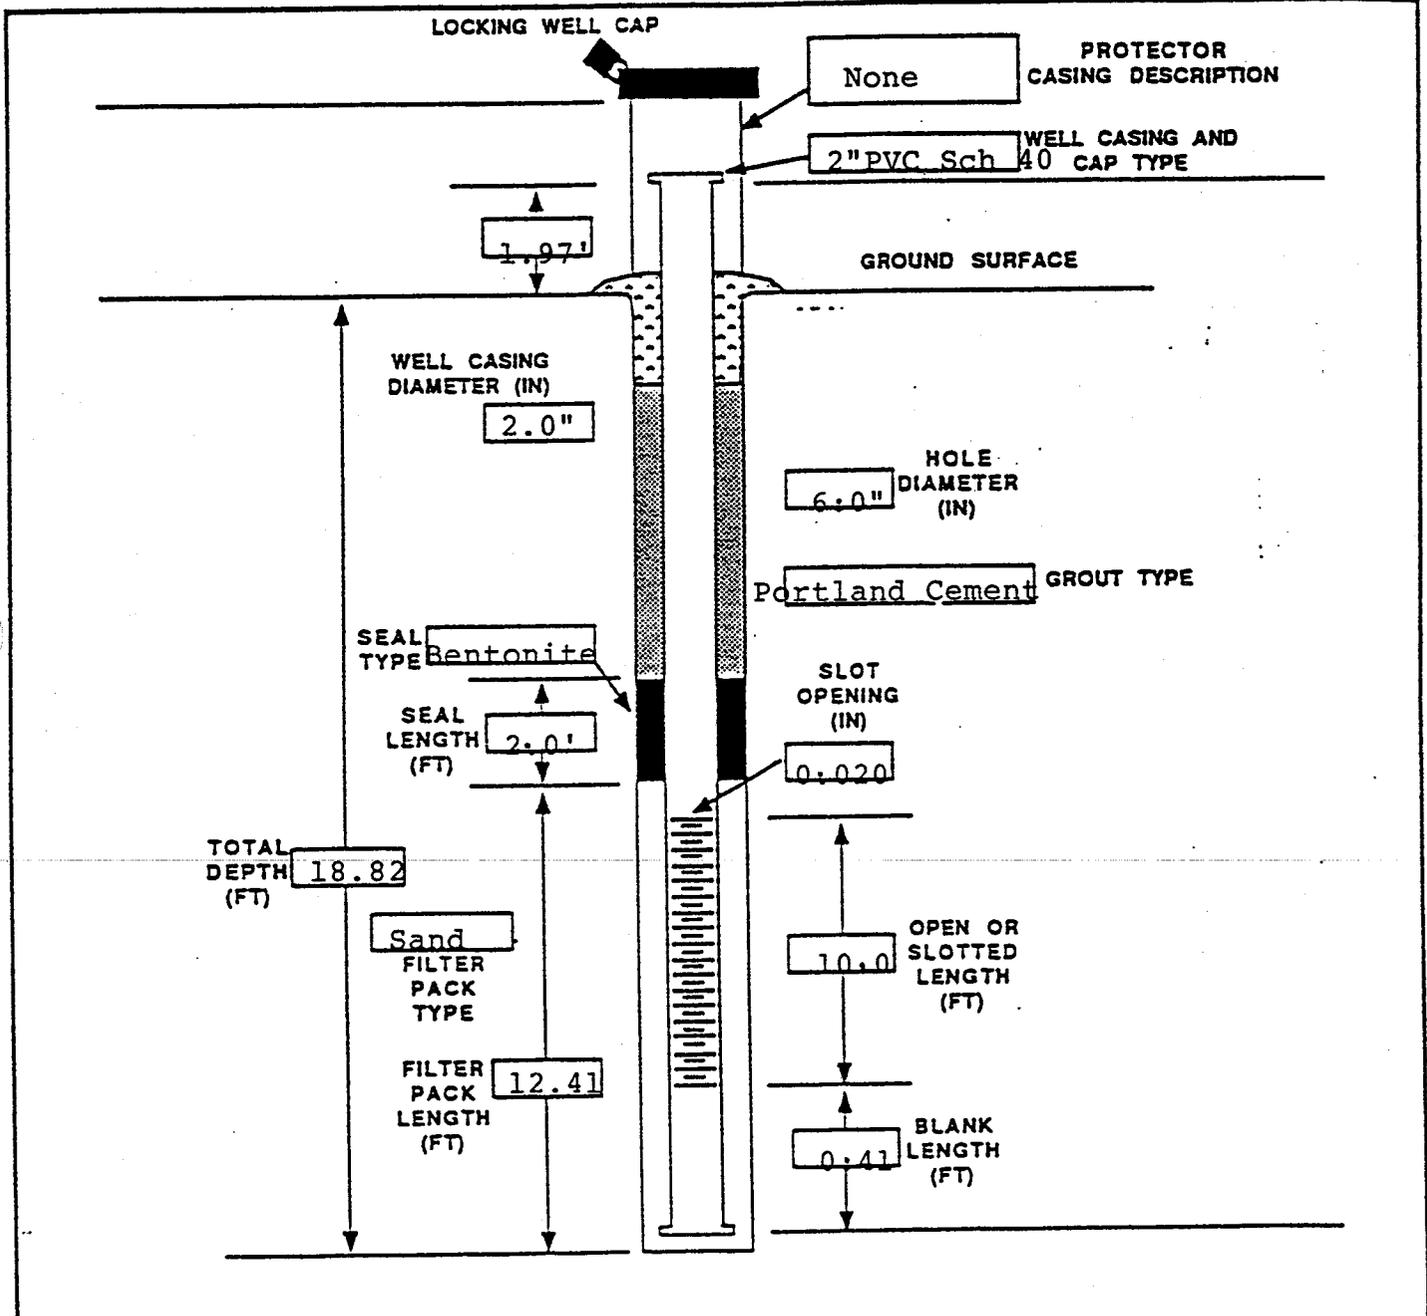

COMMENTS: Hole was drilled using 6" augers. Well was

developed using hand bailer

RECORD OF SOIL EXPLORATION

CLIENT The Torrington Company BORING NO. DSA-1
 PROJECT NAME Phase I Groundwater Assessment JOB NO. _____ DATE 3/22/8
 PROJECT LOCATION Sylvania, GA. STATION Drum Storage Area
 BORING METHOD 5" I.D. Hand Auger (Stainless) FOREMAN Earl Titcomb
 INSPECTOR Mark Potts



ROCK CORE DIA. _____ in.
 SHELBY TUBE O.D. _____ in.

SOIL CLASSIFICATION _____
 SURFACE ELEVATION - 181.19

DEPTH	SPT **			Shelby Tube No.
	Sample No.	Blows/ft. 3'-6 in. increments	Recovery, %	
0				
15.83				
165.81				

FOREMAN Earl Titcomb
 INSPECTOR Mark Potts

BORING & SAMPLING NOTES

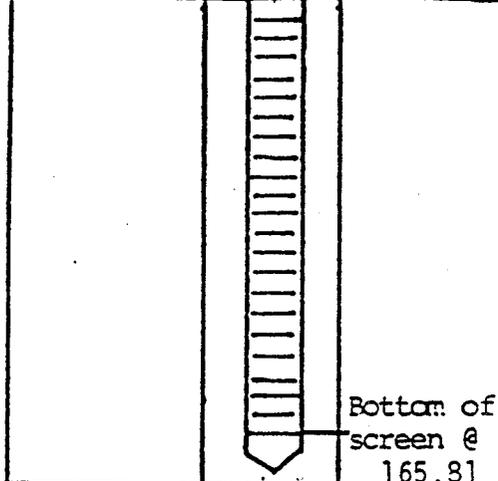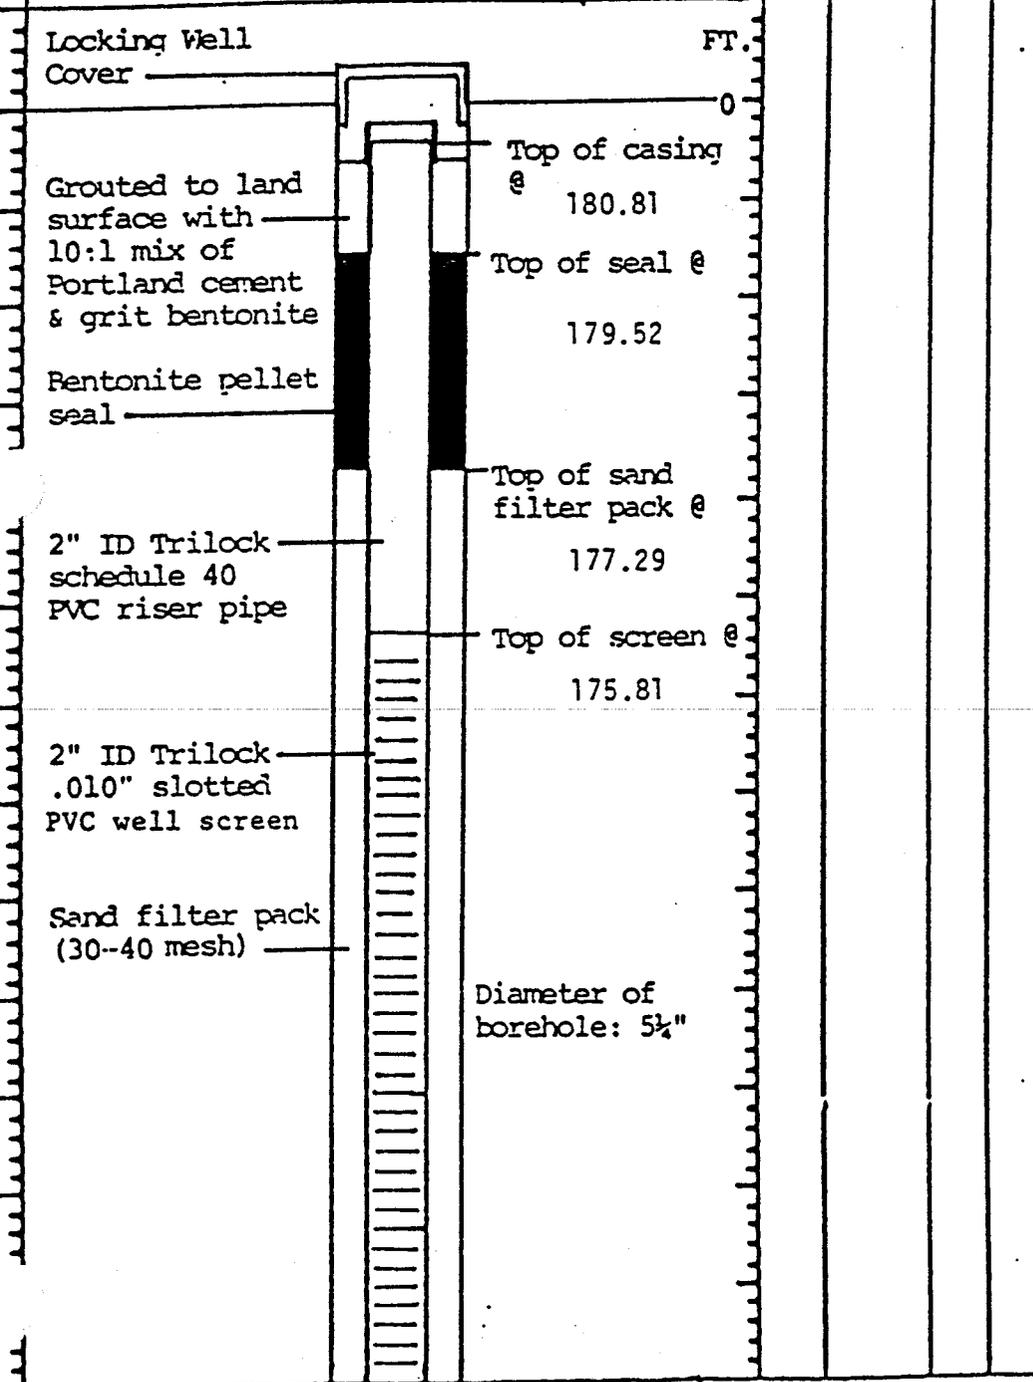

Total depth of hole: 15.83 ft

NOTE: Diagram not to scale.

BORING METHOD
 HSA - HOLLOW STEM AUGER
 CFA - CONTINUOUS FLIGHT AUGER
 DC - DRIVEN CASING

GROUND WATER NOTED ON ROGS _____ FT.
 AT COMPLETION _____ FT.

*THESE SHELBY TUBE SAMPLES OBTAINED BORING _____ DRILLED A FEET FROM BORING _____

SOIL EXPLORATION

The Torrington Company BORING NO. DSA-1
 PROJECT NAME Phase I Groundwater Assessment JOB NO. _____ DATE 3/21/87
 PROJECT LOCATION Sylvania, GA. STATION Drum storage area

BORING METHOD 5" I.D. Hard Auger (Stainless) FOREMAN Tom Bragg and W. Harley
 ROCK CORE DIA. _____ in. INSPECTOR Michael Sheehan
 SHELBY TUBE O.D. _____ in.

SOIL CLASSIFICATION	DEPTH H	SPT **			Shelby Tube No.	BORING & SAMPLING NOTES
		Sample No.	Blows in 3'-6" in. increments	Recovery, %		
SURFACE ELEVATION - 181.19						
	FT.					
(0-2.0) Orange-brown, moderately sorted, fine to medium gr., quartz sand. Possibly fill material.	0					12 Same as above except for gradual increase in yellow-brown color. Increase in purple color.
(2.0-3.0) Light gray-brown, well sorted, fine gr., quartz sand.	2					14 Distinct purple-gray color banding.
(3.0-6.0) Orange-brown, moderately sorted, fine to medium gr., quartz sand. Silt content increases with depth.	3					16 (15.0-16.0) Orange-brown, well sorted, medium gr., quartz sand. Little clay.
	4					16 (16.0-17.0) Same as above with gray-purple lenses of clay.
	6					18 (17.0-17.5) Dark purple, competent, fat clay.
(6.0-15.0) Gray-purple mottled, moderately sorted, medium gr., clayey, quartz sand. Approx. 40% clay.	6					
	8					
	10					Rational for discontinuing hole: CH horizon intersected.
	12					Total Depth: 17.5 ft.

BORING METHOD
 HSA - HOLLOW STEM AUGER
 CFA - CONTINUOUS FLIGHT AUGER
 OC - DRIVEN CASING
 MO - MUD DRILLING
 RC - ROCK CORING


GROUND WATER
 NOTED ON ROOS _____ FT.
 AT COMPLETION _____ FT.
 AFTER _____ HRS. _____ FT.

*THESE SHELBY TUBE SAMPLES OBTAINED IN BORING _____ DRILLED A FEW FEET FROM BORING _____
 **STANDARD PENETRATION TEST

WELL CONSTRUCTION DIAGRAM

PROJECT: Torrington/Sylvania
LOCATION: Underground Storage Area
WELL NUMBER: LS-1
DATE INSTALLED: 6-2-89

ELEVATION: Point - 150.32
 GROUND CASING PROTECTOR CASING
 ABOVE GROUND LEVEL ABOVE MEAN SEA LEVEL

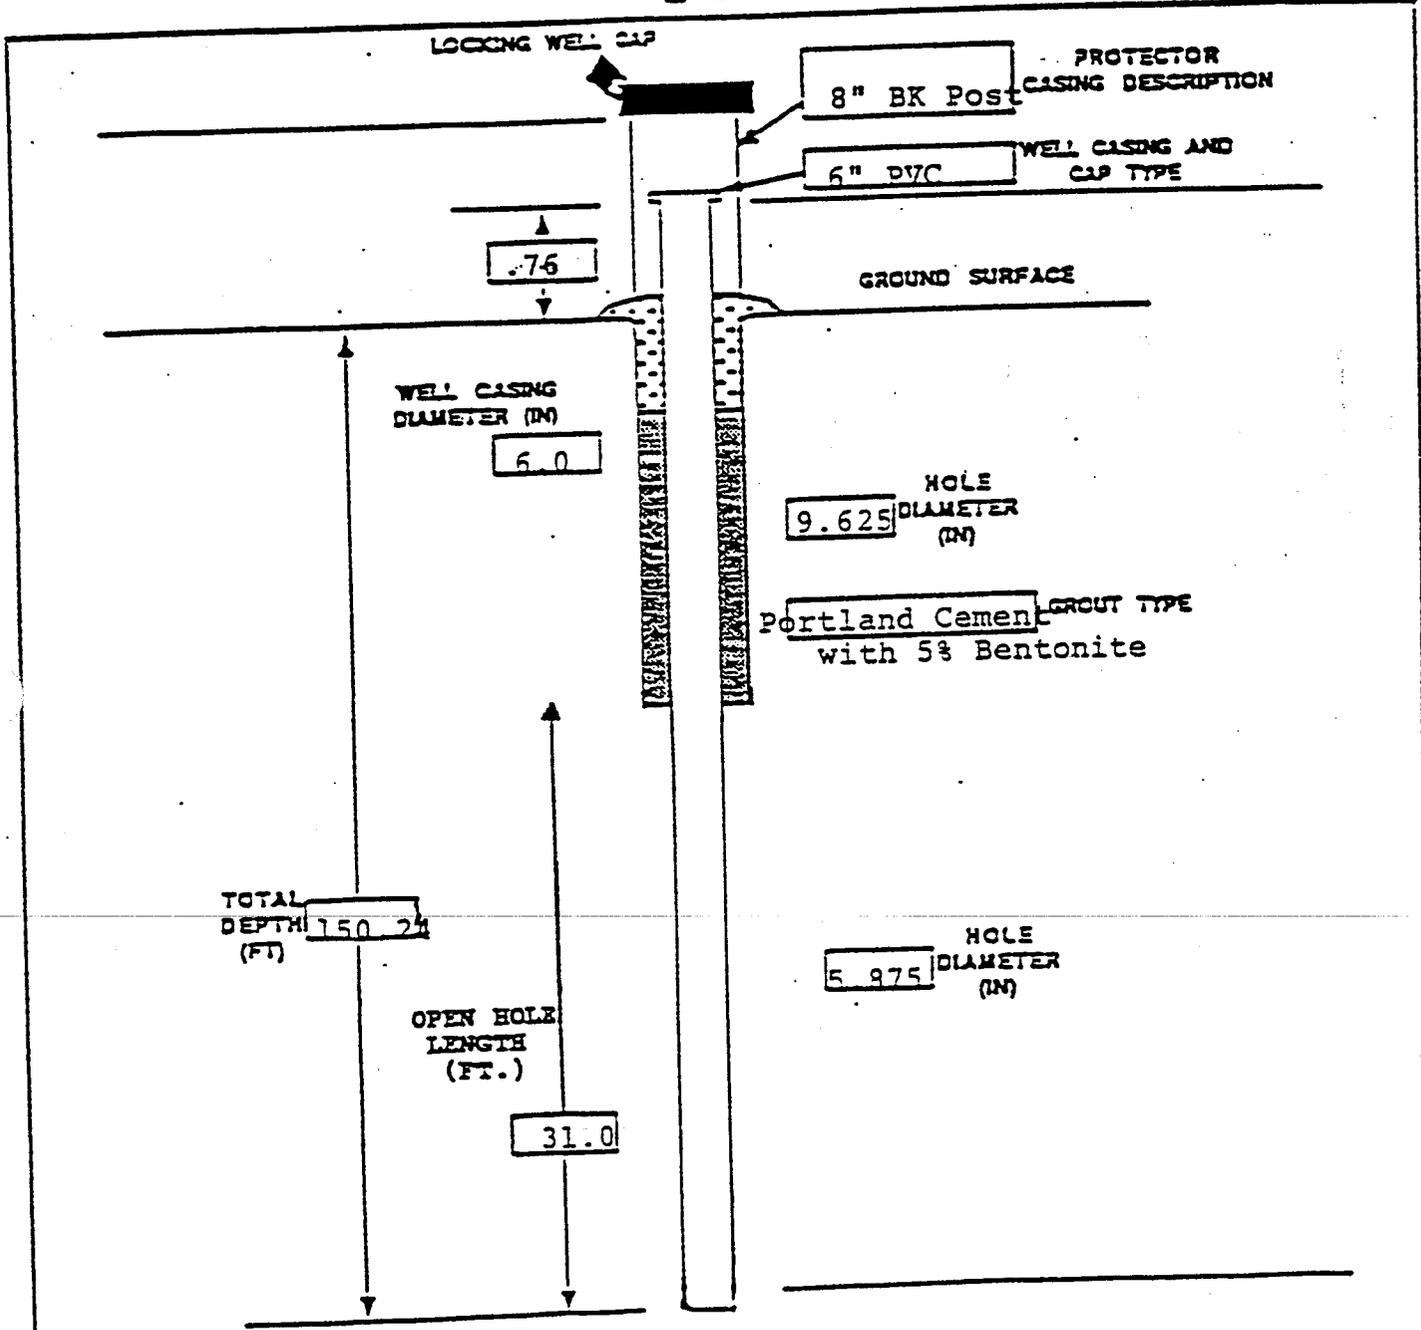

COMMENTS: Drilled 6-5/8" pilot hole to 120.5 ft. then open hole
to 9-5/8". Ran 6" ID PVC casing to 119.0 ft. cemented using
Tremie pipe. Drilled out with 5-7/8" bit to TD of 150.0 ft.
Developed well using an air compressor.

Atlanta Environmental Management Inc.
Monitoring Well Log

Date: 6-1-89

Owner:	<u>Torrington/Sylvania</u>	Screened From:	<u>N/A</u> ft. to <u> </u> ft.
Well No:	<u>LS-1</u>	Gravel Pack:	<u>N/A</u> mesh to <u> </u> ft.
Location:	<u>Underground Storage Tank Area</u>	Bentonite Seal:	<u>N/A</u> ft. to <u> </u> ft.
Driller:	<u>Chalres Hill</u>	Concrete Seal from:	<u>110</u> ft. to surface
Geologist:	<u>Ron Yarborough</u>	Water Level:	<u>77</u> ft. below well top.
Drilling Method:	<u>Mud Rotary</u>	Well top elevation:	<u>Not surveyed</u> ft.

2150.32

Depth (feet)		Lithology	Remarks
From	To		
0.0	92.0	See well logs for UST-ID and UST-IDD	All Samples collect from drilling mud
92.0	98.0	CH-60% light gray, light green soft-medium firm, very sandy	Sample #1 92.0-98.0
		LS-40% Buff-white hard fossiliferous limestone	Sample #2 98.0-103.0
	103.0	50% clay 50% limestone as above	Sample #3 103.0-108.0
	108.0	60% Clay 40% limestone as above	Sample #4 108.0-113.0
	113.0	LS-60% Buff white, hard fossiliferous limestone with abundant shell fragments	
		CH-40% light gray, light green, soft, very sandy	Sample #5 113.0-118.0
	116.0	LS-80% CH 20% as above	Sample #6 116.0-120.5
116.0	120.5	LS-dark gray, dark green, dense, micro crystalline with trace	

Atlanta Environmental Management Inc.
Monitoring Well Log

Date: 5-2-83

Owner: <u>Torrington/Sylvania</u>	Screened From: <u>N/A</u> ft. to <u> </u> ft.
Well No: <u>LS-1</u>	Gravel Pack: <u>N/A</u> mesh to <u> </u> ft.
Location: <u>Underground Storage Tank Area</u>	Bentonite Seal: <u>N/A</u> ft. to <u> </u> ft.
Driller: <u>Charles Hill</u>	Concrete Seal from <u>110</u> ft. to surface
Geologist: <u>Ron Vathorough</u>	Water Level: <u>--</u> ft. below well top.
Drilling Method: <u>Mud Rotary</u>	Well top elevation: <u>Not surveyed</u> ft.

Depth (feet)		Lithology	Remarks
From	To		
		white buff hard fossiliferous limestone with shell fragments	
120.5	125.0	LS-Tan, white, hard, fossiliferous limestone	Sample #7 120.5-125.0
	130.0	LS-As above	Sample #8 125.0-130.0
	135.0	LS-As above	Sample #9 130.0-135.0
	138.0	Lost returns	
	145.0	LS-Tan, white, hard, fossiliferous, limestone	Sample #10 from plugged bit at 145.0
		Drilled from 138.0 ft. to 150.0	
		without returns. No samples recovered	

RECORD OF SOIL EXPLORATION


UST-1

CLIENT The Torrington Company BORING NO. _____
 PROJECT NAME Phase I Groundwater Assessment JOB NO. _____ DATE 3/22/87
 PROJECT LOCATION Sylvania, GA. STATION Underground Storage Tank Area
 BORING METHOD 5" I.D. Hand Auger (Stainless)

ROCK CORE DIA. _____ in. DEPTH _____ FT.
 SHELBY TUBE O.D. _____ in. SPT **
 SOIL CLASSIFICATION _____
 SURFACE ELEVATION- 181.98

FOREMAN Earl Titcomb
 INSPECTOR Mark Potts

BORING & SAMPLING
NOTES

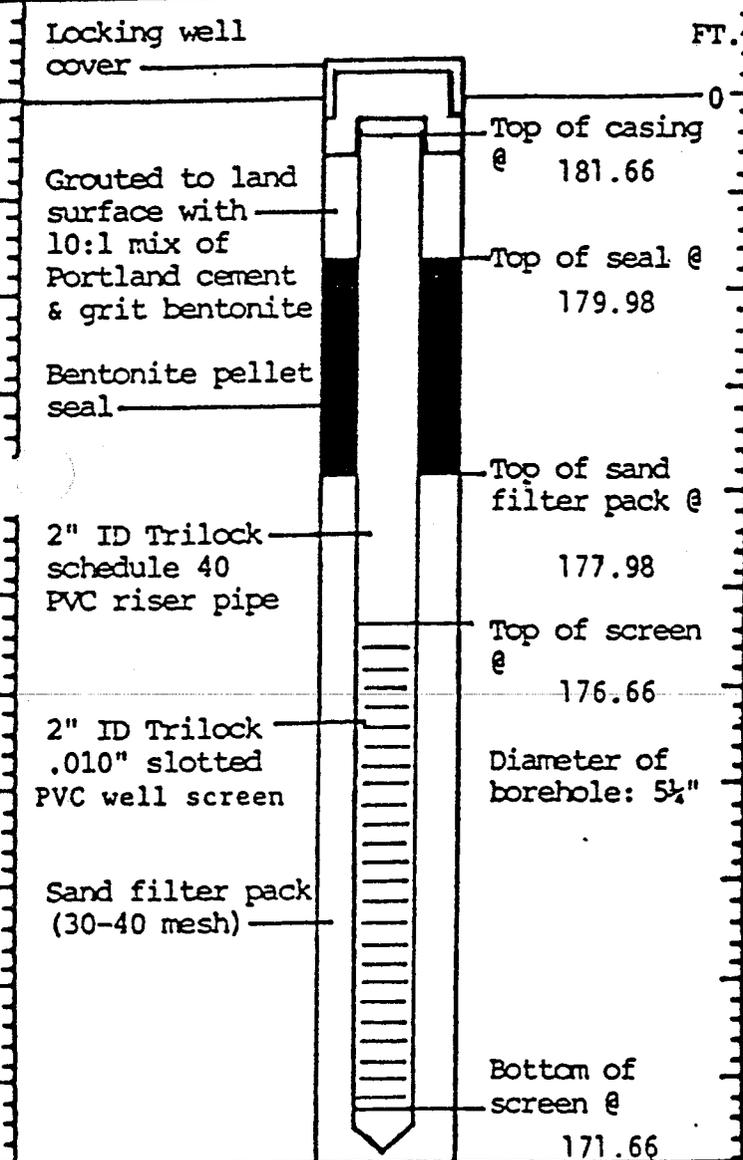

Total depth of hole: 10.77 ft

NOTE: Diagram not to scale

BORING METHOD
 HSA - HOLLOW STEM AUGER
 CFA - CONTINUOUS FLIGHT AUGER
 OC - DRIVEN CASING
 MC - MUD DRILLING

GROUND WATER
 NOTED ON RODS _____ FT.
 AT COMPLETION _____ FT.

*THESE SHELBY TUBE SAMPLES OBTAINED IN BORING _____ DRILLED A FEW FEET FROM BORING _____

SOIL EXPLORATION

PROJECT NAME The Torrington Company BORING NO. IIST-1
 PROJECT NAME Phase I Groundwater Assessment JOB NO. _____ DATE 3/21/87
 PROJECT LOCATION Sylvania, GA. STATION Underground storage tank area

BORING METHOD 5" I.D. Hand Auger (Stainless)
 ROCK CORE DIA. _____ in.
 SHELBY TUBE O.D. _____ in.

FOREMAN Tom Bragg
 INSPECTOR Michael Sheehan

SOIL CLASSIFICATION	DEPTH	SPT **			BORING & SAMPLING NOTES
SURFACE ELEVATION - 181.98	FT.	Sample No.	Blows in 2' x 1/4" increments	Recovery, %	
(0-1.0) Light gray, well sorted, fine gr., quartz sand.	0				
(1.0-5.0) Light orange-brown, moderately sorted, fine to medium gr., quartz sand with minor silt.	1				
	2				
	4				
	5				
(5.0-9.5) Light orange-brown, moderately sorted, fine to medium gr., quartz sand with approx. 20-30% silt. Gray and purple mottling and small (2 cm long) reddish clay lenses.	6				Rational for discontinuing hole: CH horizon intersected. Total Depth: 10.0 ft.
	8				
(9.5-10.0) Dark purple, yellow brown, and gray, competent, fat clay.	9.5				
	10				
	12				


BORING METHOD
 HSA - HOLLOW STEM AUGER
 CFA - CONTINUOUS FLIGHT AUGER
 OC - DRIVEN CASING
 MO - MUD DRILLING
 RC - ROCK CORING

GROUND WATER
 ▽ NOTED ON RODS _____ FT.
 ▽ AT COMPLETION _____ FT.
 ▽ AFTER _____ HRS. _____ FT.

*THESE SHELBY TUBE SAMPLES OBTAINED IN BORING _____ DRILLED A FEW FEET FROM BORING _____
 **STANDARD PENETRATION TEST

PROJECT: Torrington Company
 LOCATION: Sylvania, Georgia
 WELL NUMBER: HST-1D
 DATE INSTALLED: November 6-7, 1988

ELEVATION: 184.96 FT (TOC) AMSL
 GROUND CASING PROTECTOR CASING
 ABOVE GROUND LEVEL ABOVE MEAN SEA LEVEL

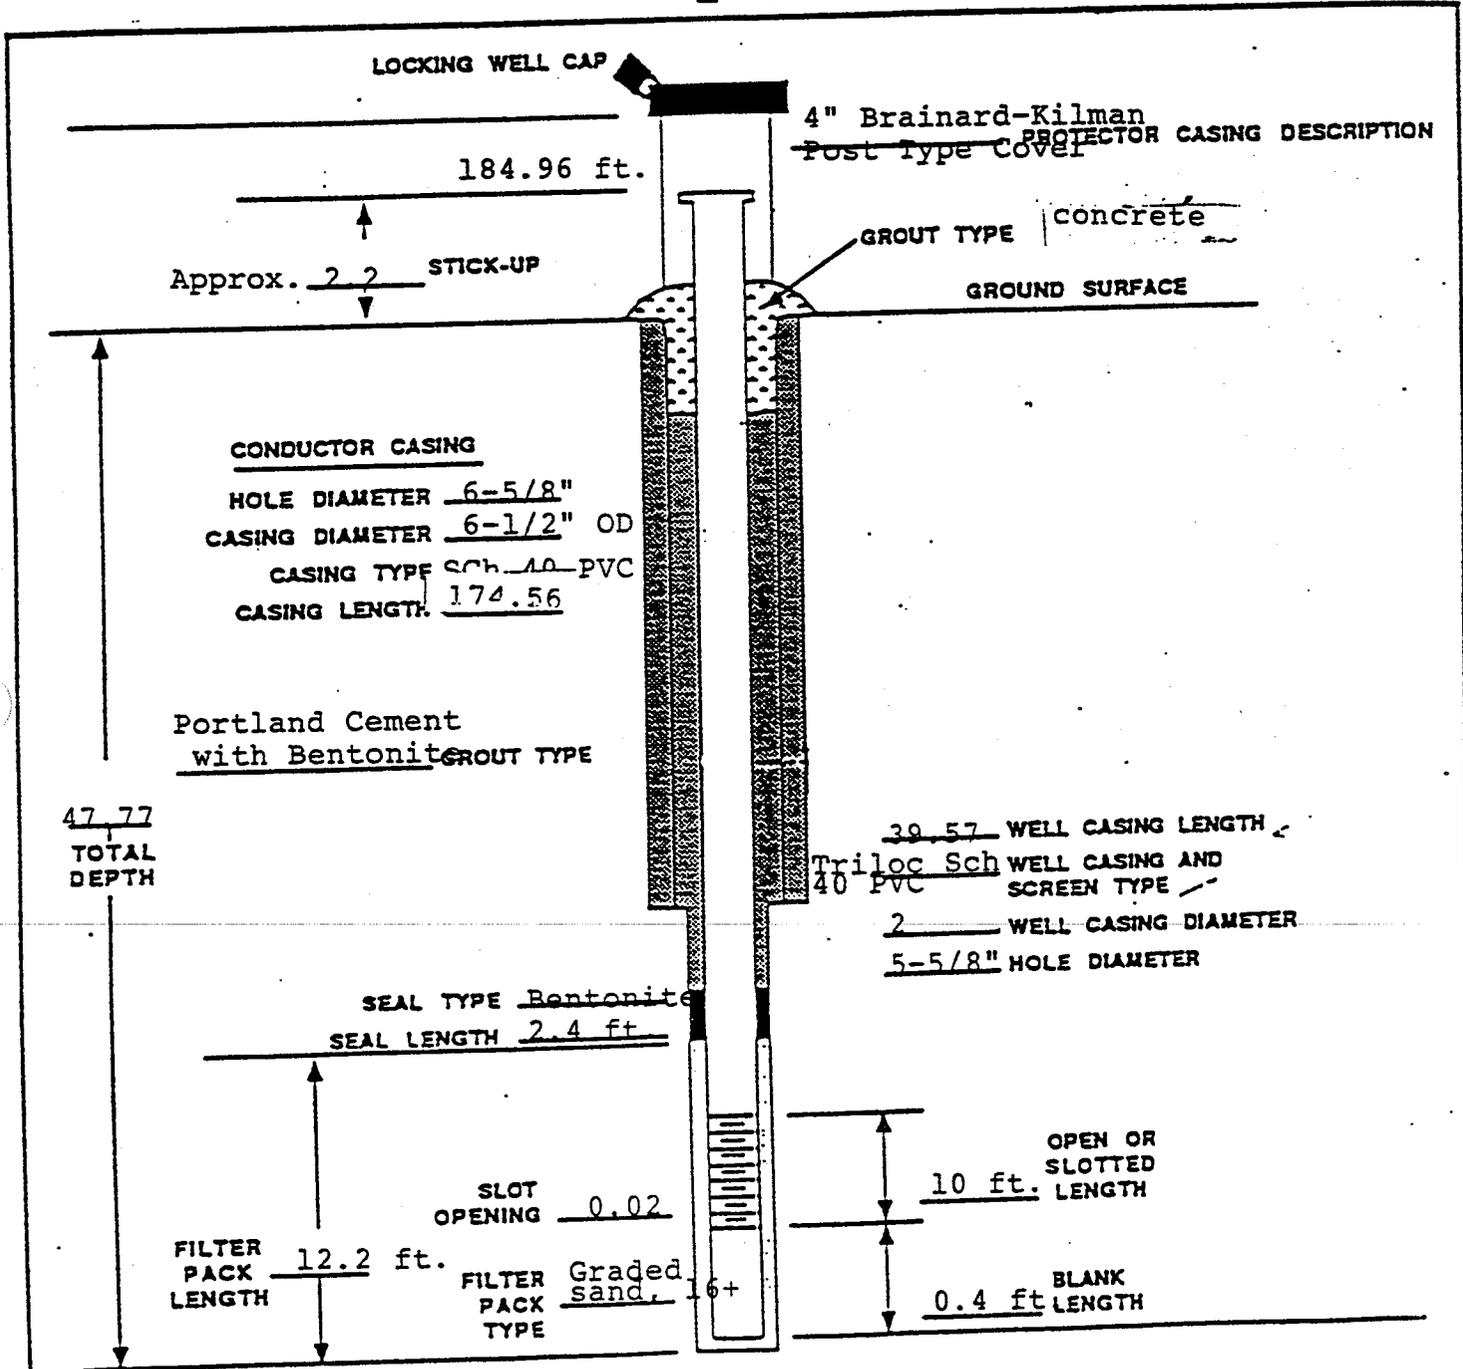

COMMENTS: The well was installed using hollow-stem augers to set an upper casing into the confining clay layer. Water was bailed from the hole. Mud drilling proceeded through the clay layer to total depth.

Atlanta Environmental Management Inc.
Monitoring Well Log


Date: November 7-8, 1988

Owner: Torrington Company Screened From: _____ ft. to _____ ft.
 Well No: UST-1D Gravel Pack: _____ mesh to _____ ft.
 Location: Sylvania, GA Bentonite Seal: _____ ft. to _____ ft.
 Concrete Seal from _____ ft. to surface
 Driller: Paul Clawson Water Level: _____ ft. below well top.
 Geologist: M. Potts/E. Titcomb Well top elevation: 184.96 ft. ft. (TOC)
 Drilling Method: 6-3/4"OD HSA 5-5/8" Drag Bit

Depth (feet) From	To	Lithology	Remarks
		See the well log for monitoring UST-1 down to the confining clay layer. The HSA augers bored to 14.0 ft. A piece of 6" Sch. 80 PVC was driven into the clay to a depth of 14.75 ft.	
0	14	CL-Light greenish gray sandy clay, = 15% sand overall, but up to 50% in places, clay blebs intermixed. Poorly sorted	Sample #1 14-15.5 ft SPT-8
		Light gray stiff fat clay with maroon blebs and thin 1/2" orange clayey sand layers, minor sand and silt. (approx. 10%) (CH)	Sample #2 20.5-22.0-SPT-6
		Light greenish gray stiff, sandy (fine) to silty clay up to 20% sand (CL)	Sample #3 25.5-27.0ft -SPT-4
		Same as above	Sample #4 30.5-32.0-SPT-14
		Light green stiff fat clay with up to 10% medium sand intermixed (CL-CH)	Sample #5 35.5-37.0-spt-10
38		Light greenish gray silty fine to medium sand, poorly sorted up to 20% fines	Sample #6 40.5-42.0=SPT-3

PROJECT: TORRINGTON CO.
 LOCATION: Sylvania, Georgia
 WELL NUMBER: WST-7D
 DATE INSTALLED: November 6-7, 1988.

ELEVATION: 180.96 Ft. AMSL (TOC)
 GROUND CASING PROTECTOR CASING
 ABOVE GROUND LEVEL ABOVE MEAN SEA LEVEL

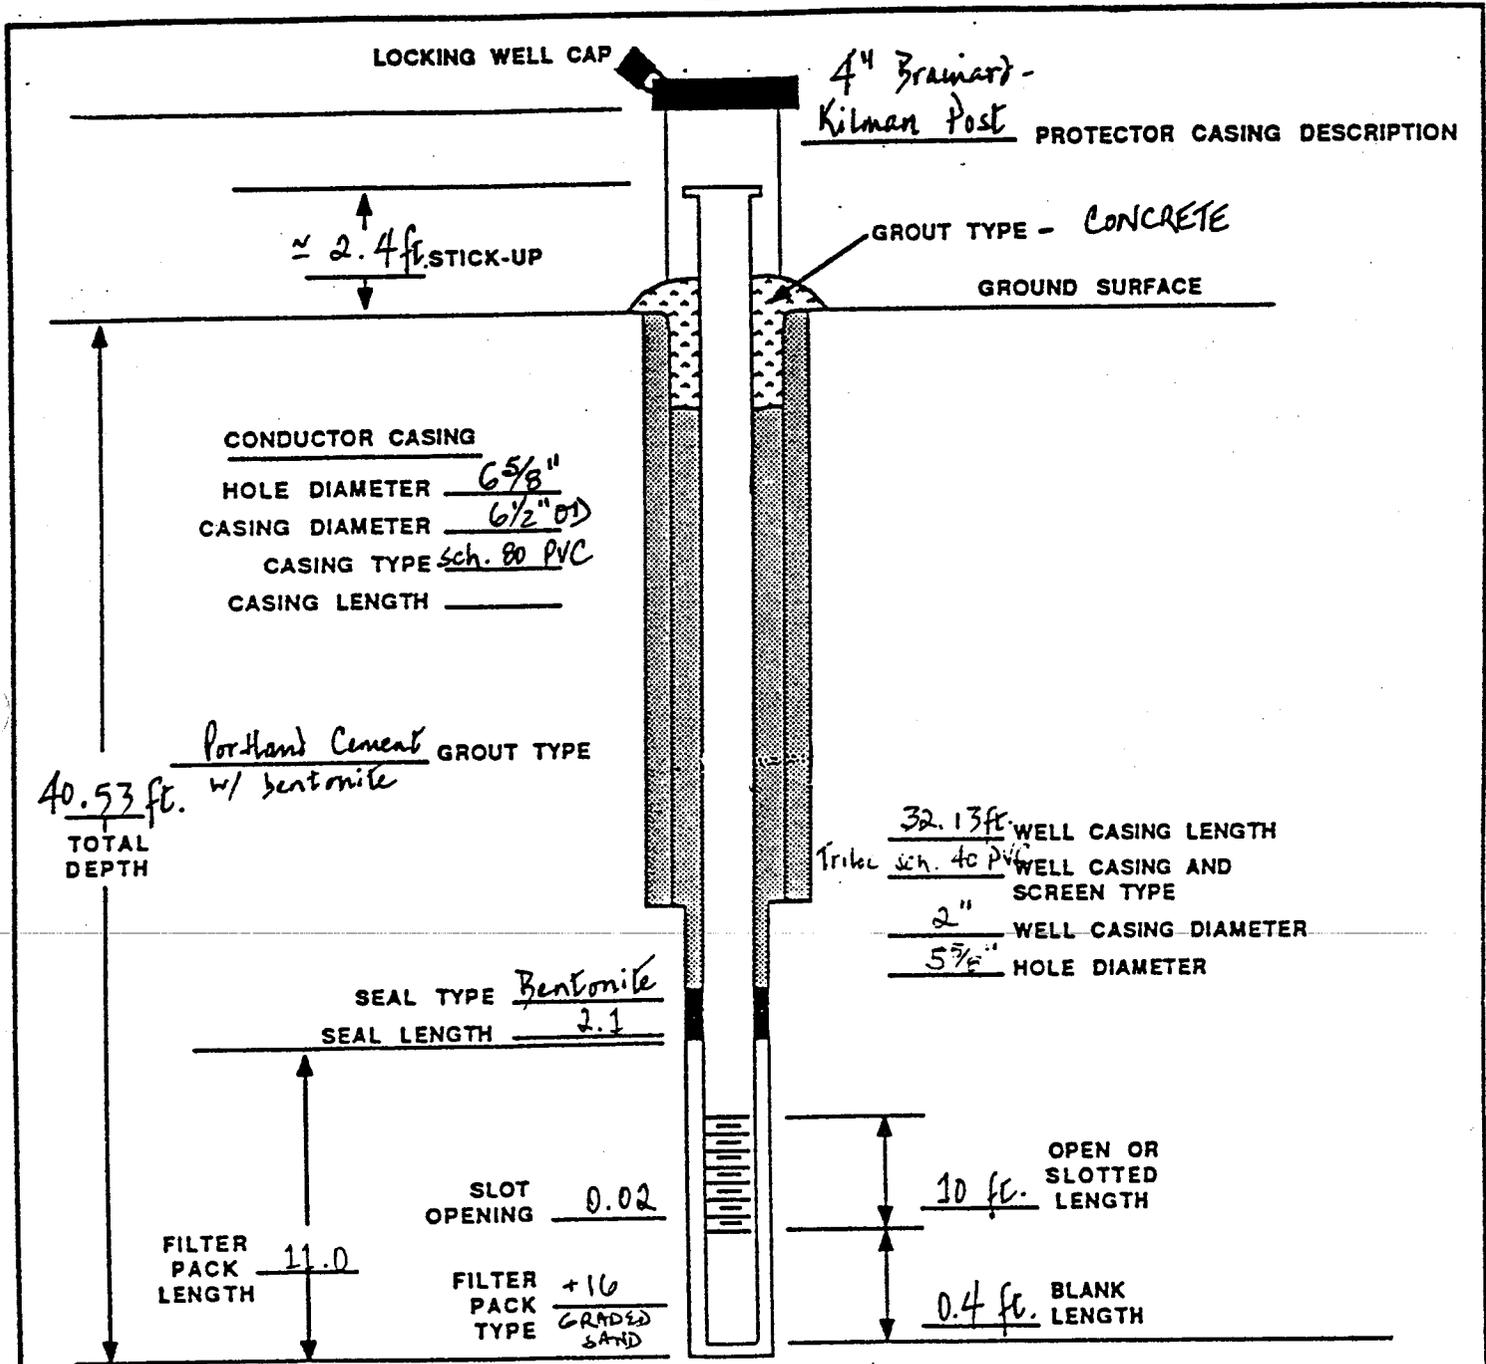

COMMENTS: An upper casing was set into the confining clay layer (C4). Angers were used to this depth. The upper casing was driven at least 6" into the clay. Mud rotary drilling was used to total depth. The well was developed by bailing. Water level was 27.92 ft. below TOC on 11.7.88

Atlanta Environmental Management Inc.
Monitoring Well Log

Date: November 5-6, 1988

Owner: TEARINGTON CO.
Well No: WST-7D
Location: Sylvania, GA

Driller: PAUL CLAWSON
Geologist: E. THOMPSON
Drilling Method: HSA 6 5/8" OD to CLAY
Mini Rotary 5 5/8" Drag Bit Below


Water Level: 27.92 ft. below well top. (i.e. 7.88')
Well top elevation: 180.46 AMSL ft. (TOC)

Depth (feet)		Lithology	Remarks
From	To		
		for log of 0 to 15.5 ft see the well log for WST-7S.	6" sch. OD PVC was set to a depth of 15.4 ft BLS. It was driven the last 6 inches to seal off the shallow water table.
11	20.5	Stiff pale olive green clay, some reddish mottling. (CH)	SAMPLE 4 20.5 - 22. SPT-13
20.5		Pale green gray sandy clay, 15% silty zone.	SAMPLE 5 25.5 - 27 SPT-17
	30.5	26.5 - 27 ft. thin sand layer at 30.9 ft. high sand content (up to 10%)	
30.5	31.5	Pale green gray sandy clay - largely silty (SC-C4)	SAMPLE 6 30.5 - 32 SPT-E
31.5	35.5	Orange medium to coarse sand - some small gravel with greenish gray clay layers (SP SC)	SAMPLE 7 35.5 - 37.0 SPT-
35.5		Greenish gray clayey medium to coarse sand (SC)	SAMPLE 8 40.5 - 42.0 SPT-
		Bottom of HCB - 42.0 feet. - At least 10 ft. below bottom of confining clay layer - into the uppermost aquifer.	

WELL CONSTRUCTION DIAGRAM

PROJECT: Torrington/Sylvania
 LOCATION: Parking Lot at UST Area
 WELL NUMBER: UST-14
 DATE INSTALLED: September 29 1999


ELEVATION:
 BELOW GROUND CASING PROTECTOR CASING
 ABOVE GROUND LEVEL ABOVE MEAN SEA LEVEL

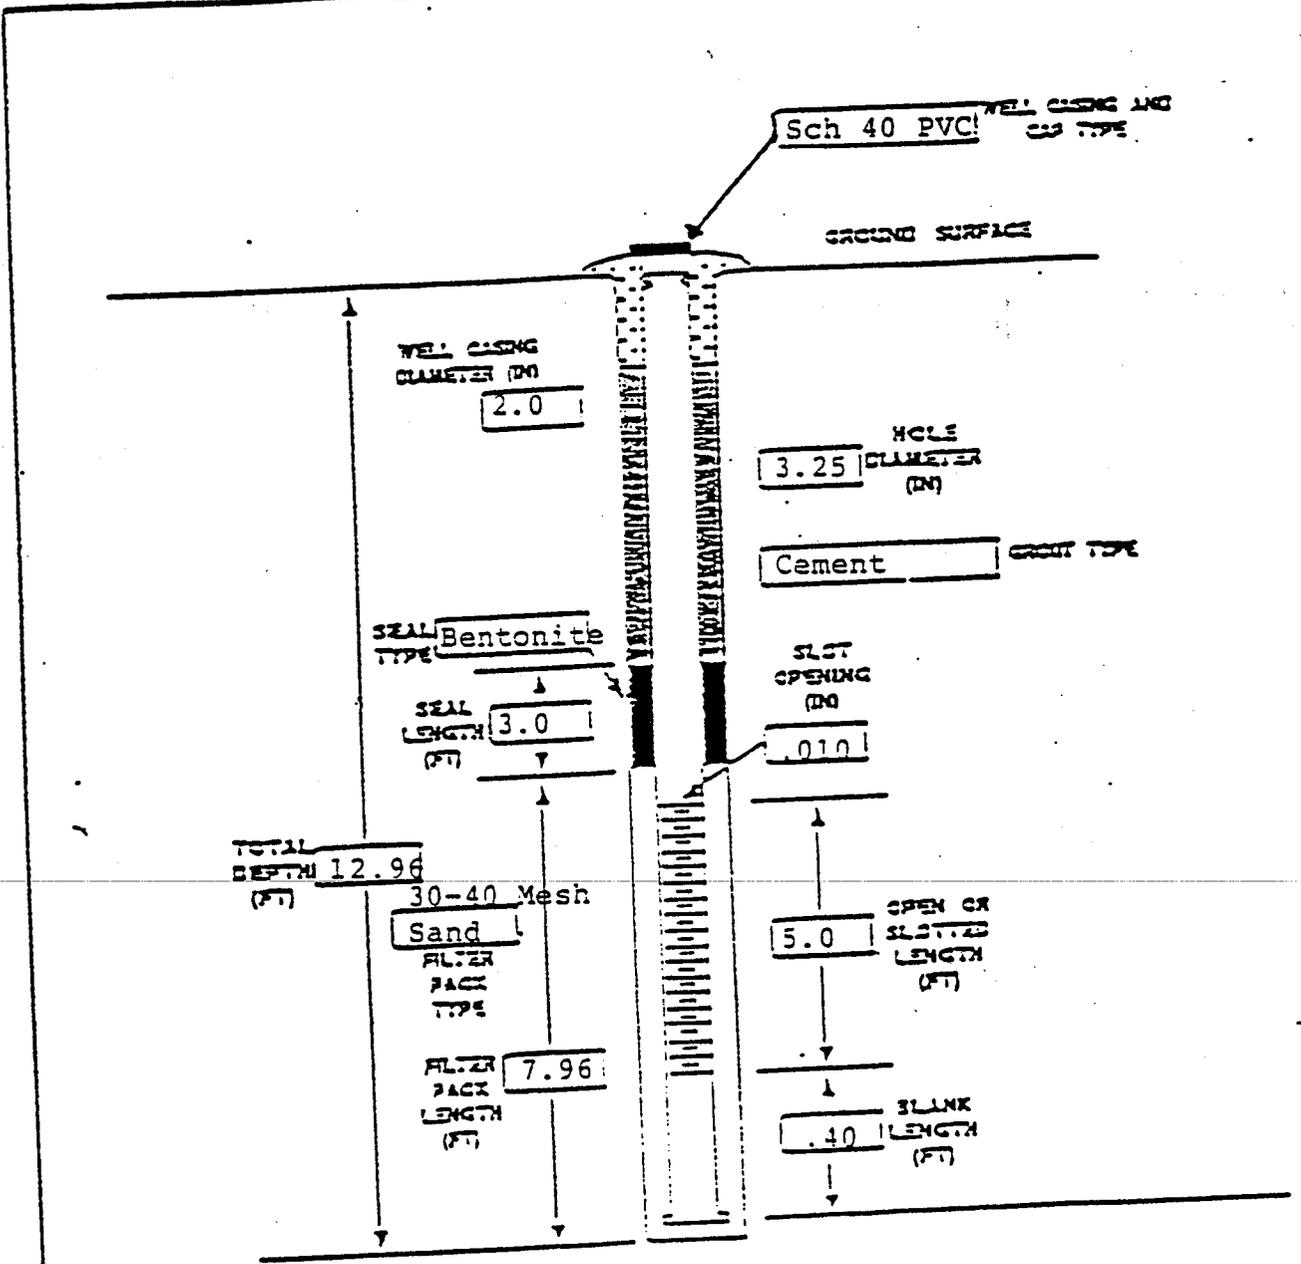

COMMENTS: Well was installed using a hand auger and
developed by surging with a PVC bailer

Monitoring Well B-3

Project: Ingersoll Rand - Sylvania	Drill Rig: CME55 HSA Rig	Top of Casing Elevation: NM
Date: October 11, 2007	Sampler: None	Initial Groundwater Depth: NM
Logged By: Ron Yarborough	Hole Diameter: 10-inch	Final Groundwater Depth: NM

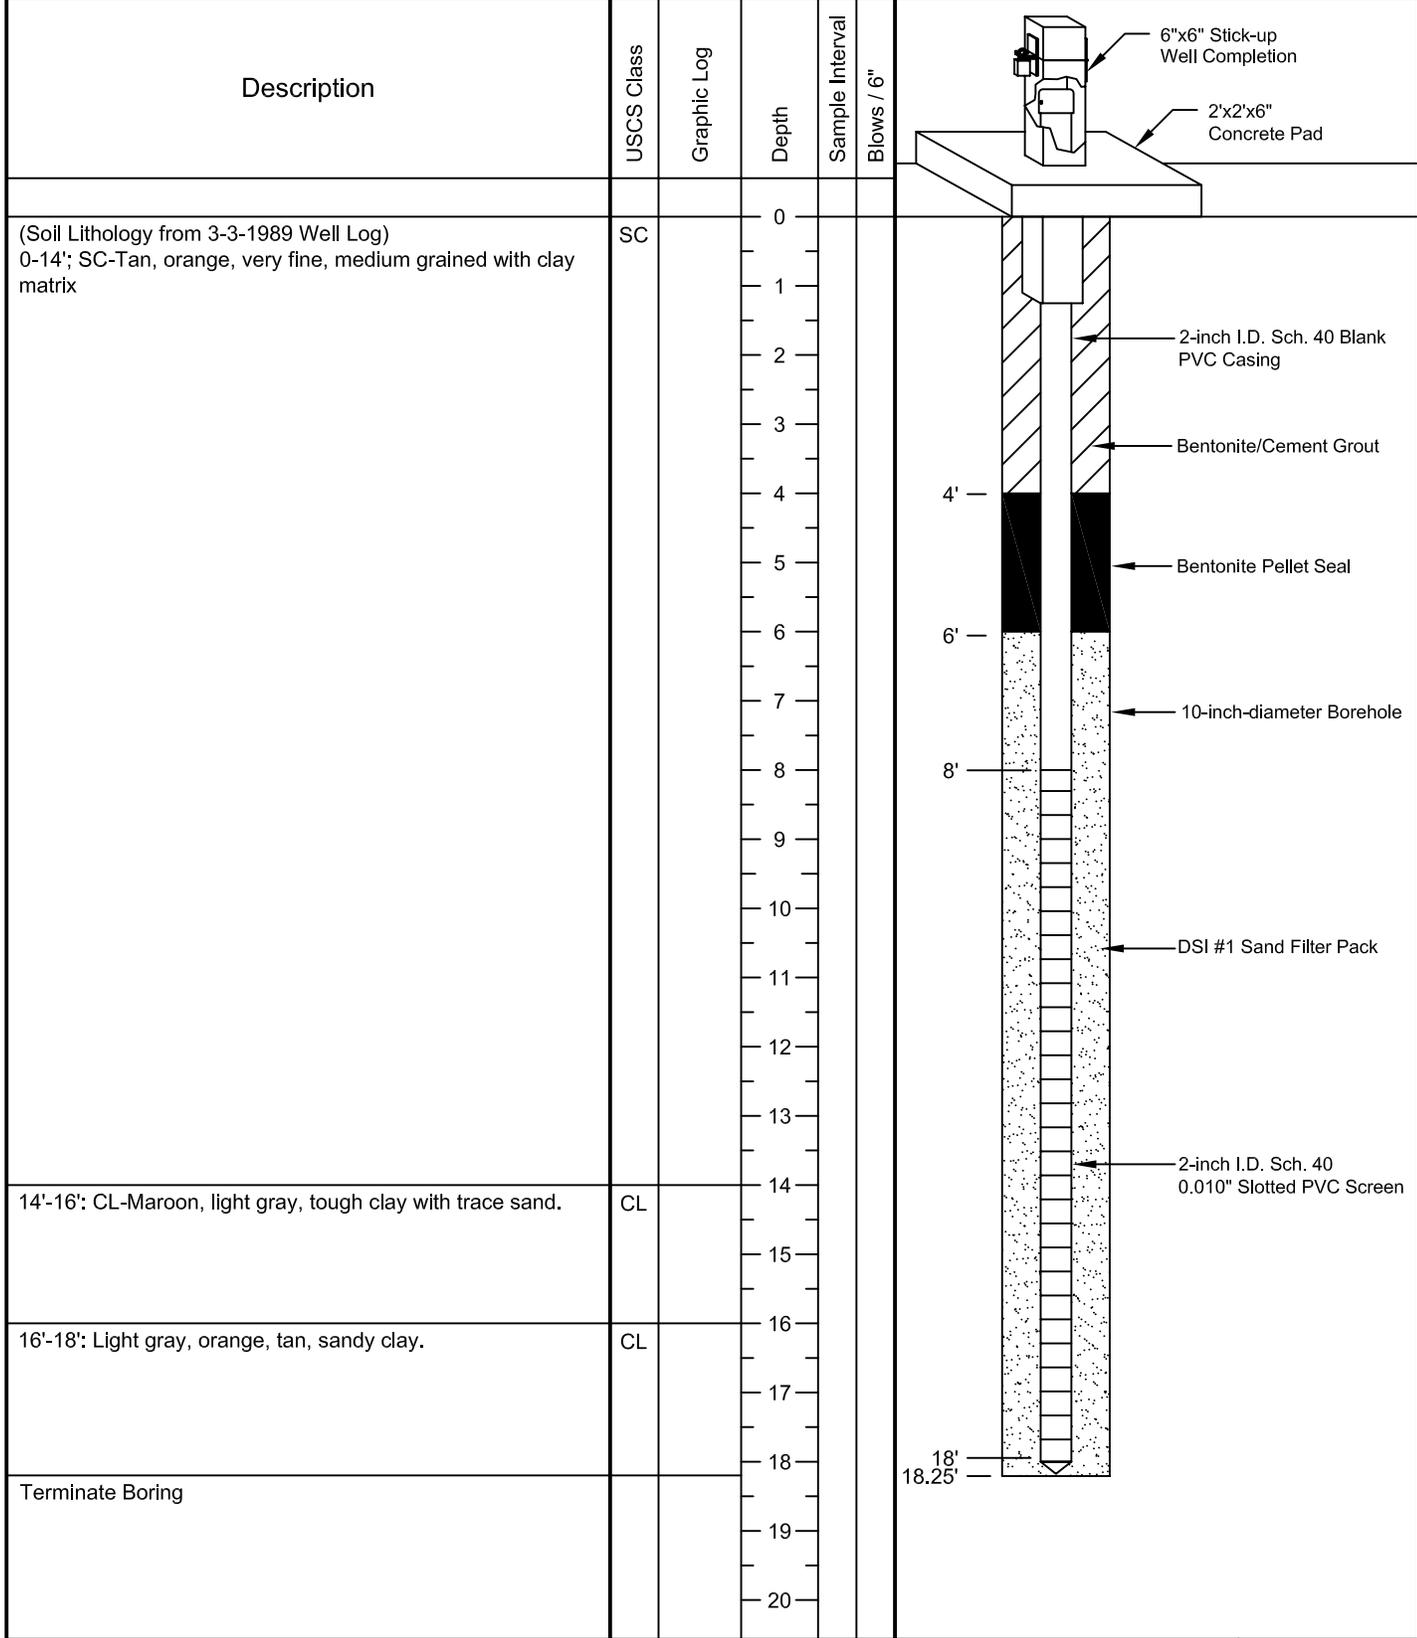

AEM Atlanta Environmental Management, Inc.
Environmental Consulting, Engineering, Hydrogeologic Services
 2580 Northeast Expressway • Atlanta Georgia 30345
 Telephone: (404) 329-9006 • Fax: (404) 329-2057

Notes:
 1. USCS = Unified Soil Classification System.
 2. Groundwater measured from top of casing.

File name: G:\DWG\1162-0801\01\B-3 Well Log Print Date: Print Date:


Project No.
1162-0801-1

Page of

B-2 AREA

WELL CONSTRUCTION DIAGRAM

PROJECT: TORRINGTON CO.
 LOCATION: SYLVANIA, GA.
 WELL NUMBER: B-2 ELEVATION: 177.82 (100)
 DATE INSTALLED: November 5, 1988 GROUND CASING PROTECTOR CASING
 ABOVE GROUND LEVEL ABOVE MEAN SEA LEVEL

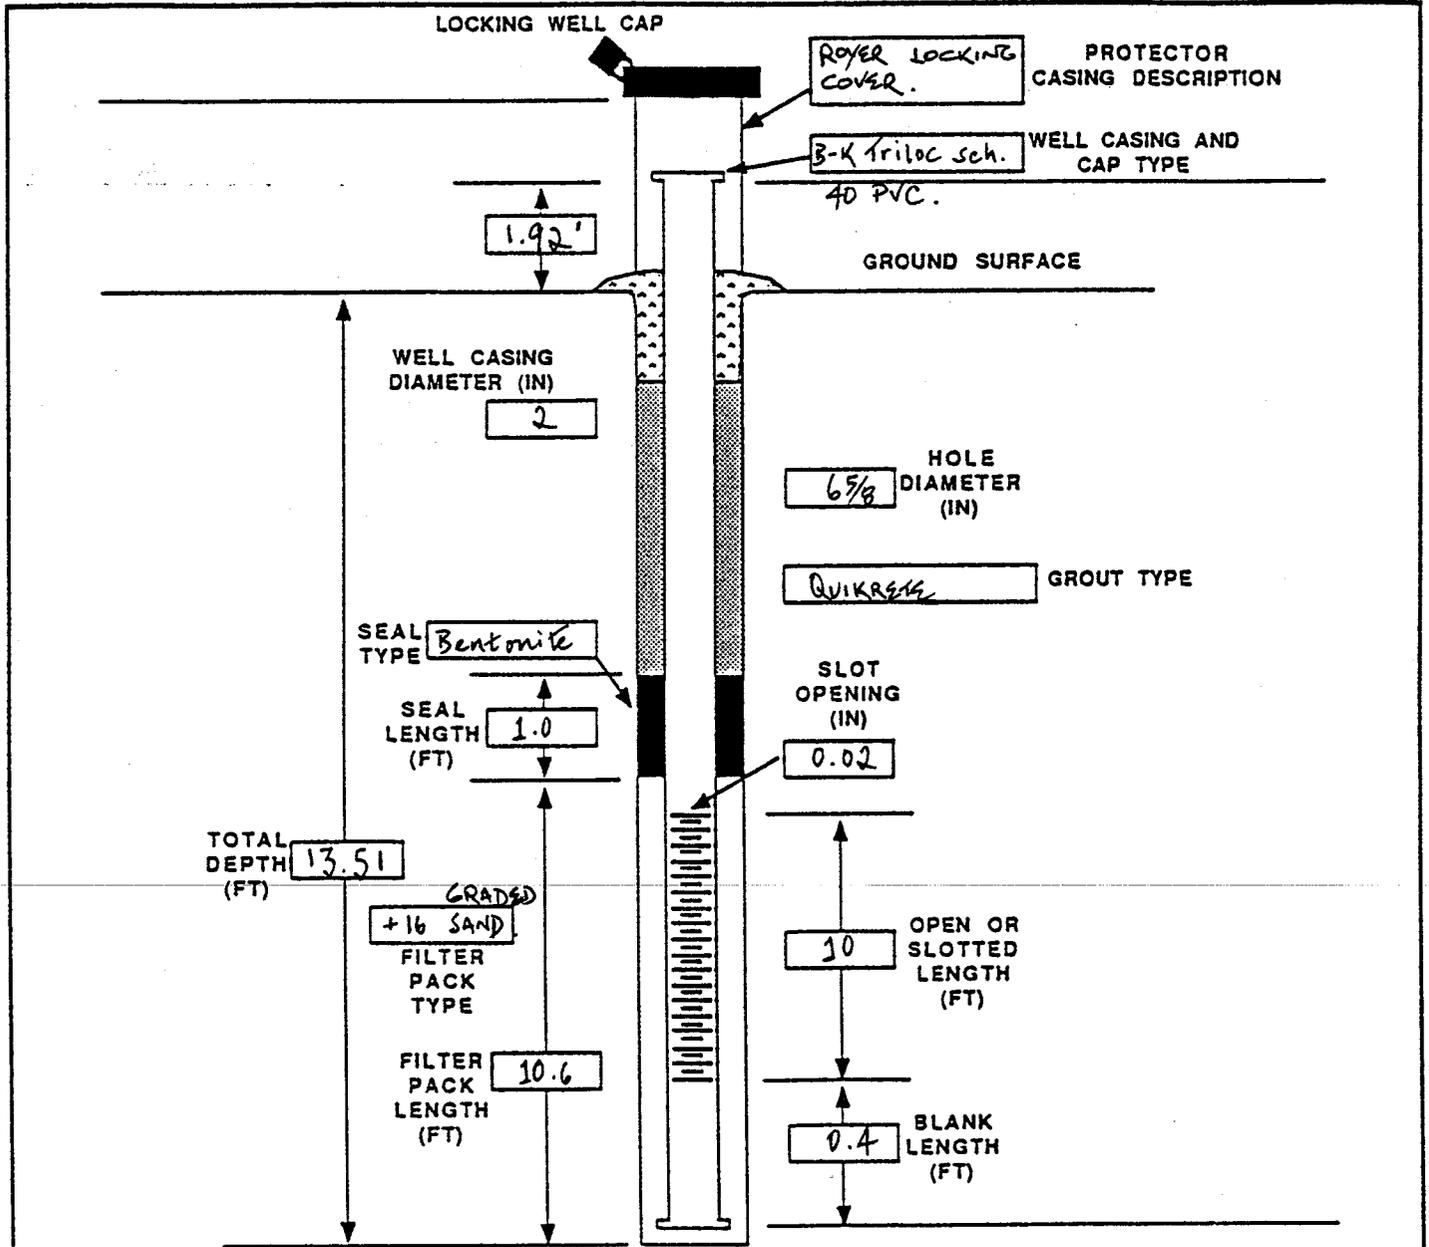

COMMENTS: Well was drilled using hollow stem augers. The well
was installed and developed using a PVC bailer. The well is
a poor producer - very little water.

WELL CONSTRUCTION DIAGRAM

Project: The Torrington Company

Location: Sylvania, Georgia


Well Number: B-2D

Date Installed: 7/1/90

Elevation: _____

Ground Casing Protector Casing

Above Ground Level Above Mean Sea Level

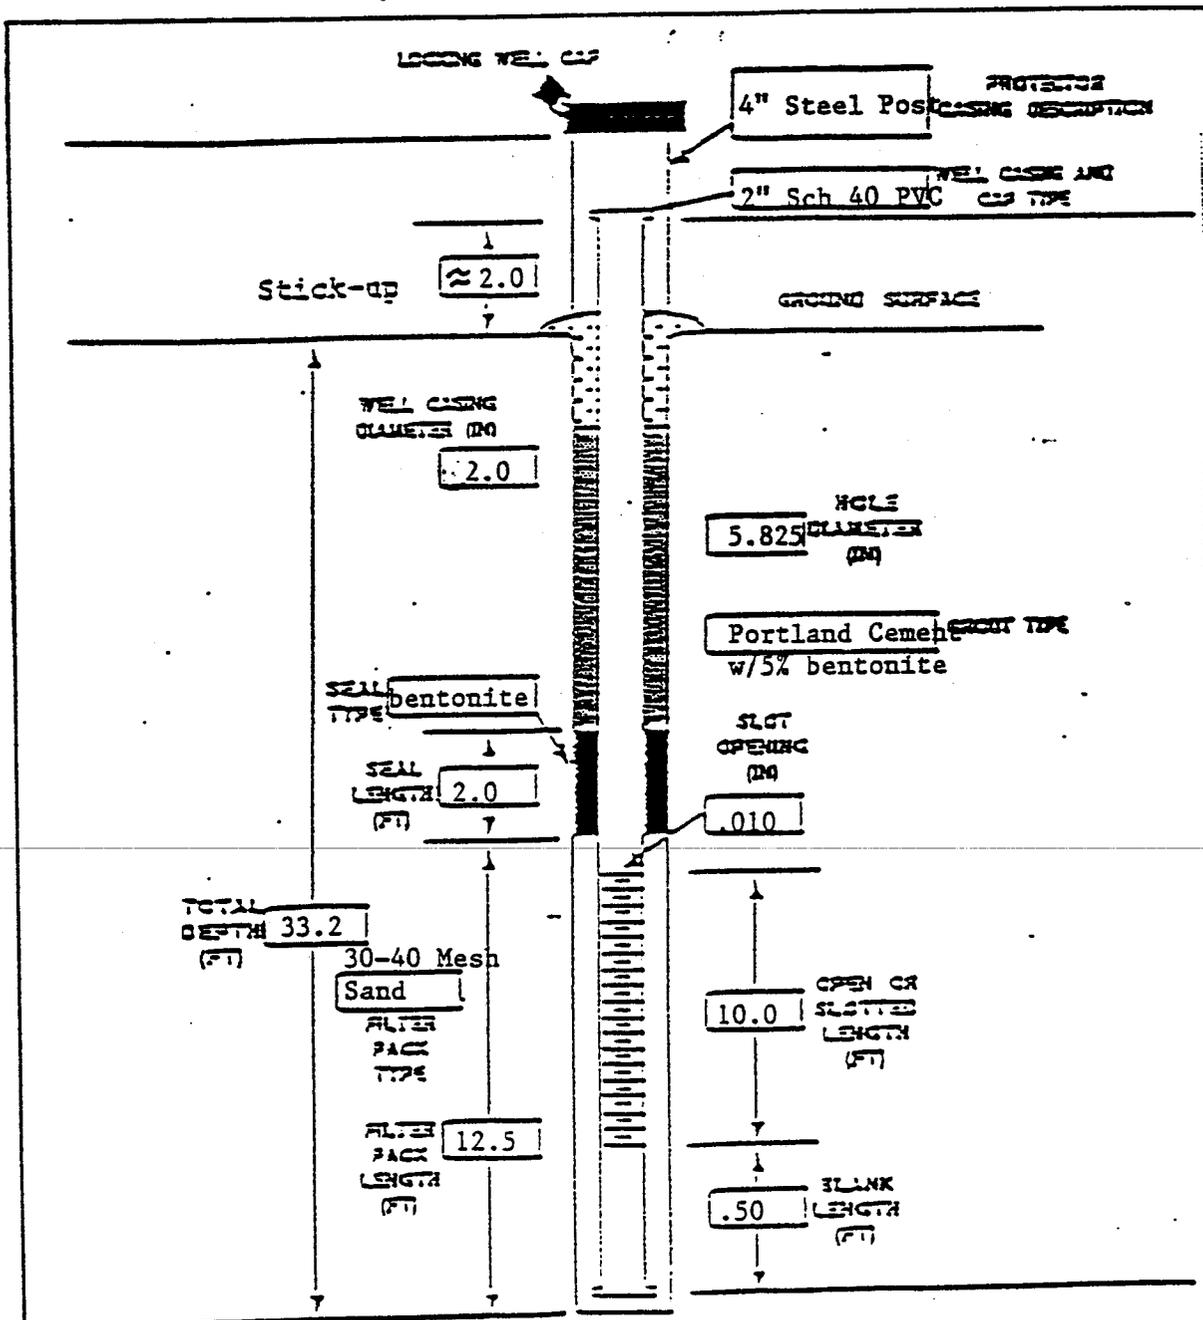

COMMENTS: Well was drilled using mud/rotary. After installation well was developed using PVC bailer.

Atlanta Environmental Management, Inc.
Monitoring Well Log

Date: 7/11/90


Owner: <u>The Torrington Company</u>	Screened From: <u>32.70</u> ft. to <u>22.70</u> ft.
Well No: <u>B-2D</u>	Gravel Pack: <u>30-40</u> mesh to <u>20.7</u> ft.
Location: <u>Sylvania, Georgia</u>	Bentonite Seal: <u>20.7</u> ft. to <u>18.7</u> ft.
<u>B-2 Area</u>	Concrete Seal from <u>18.7</u> ft. to surface
Driller: <u>Paul Clawson</u>	Water Level: <u>24.26</u> ft. below well top
Geologist: <u>Ron Yarborough</u>	Well top elevation: _____ ft.
Drilling Method: <u>Mud/Rotary</u>	

Depth (feet)		Lithology	Remarks
From	To		
0.0	15.5	See well log for well B-2	
19.0	20.5	CL-light gray light green sandy clay 10-15% sand	Sample #1 19.0'-20.5'
24.0	25.5	SC-orange, light gray, coarse grained to fine grained sand with 10-15% clay	Sample #2 24.00'-25.5'
	30.5	SC-orange, light gray coarse grained to fine grained clayey sand with approximately 5% clay	Sample #3 29.0'-30.5'
		Well was developed by using a PVC bailer	

WELL CONSTRUCTION DIAGRAM

PROJECT: The Torrington Company
 LOCATION: Sylvania, Georgia
 WELL NUMBER: B-2DD
 DATE INSTALLED: 12/11/90

ELEVATION: _____
 GROUND CASING PROTECTOR CASING
 ABOVE GROUND LEVEL ABOVE MEAN SEA LEVEL

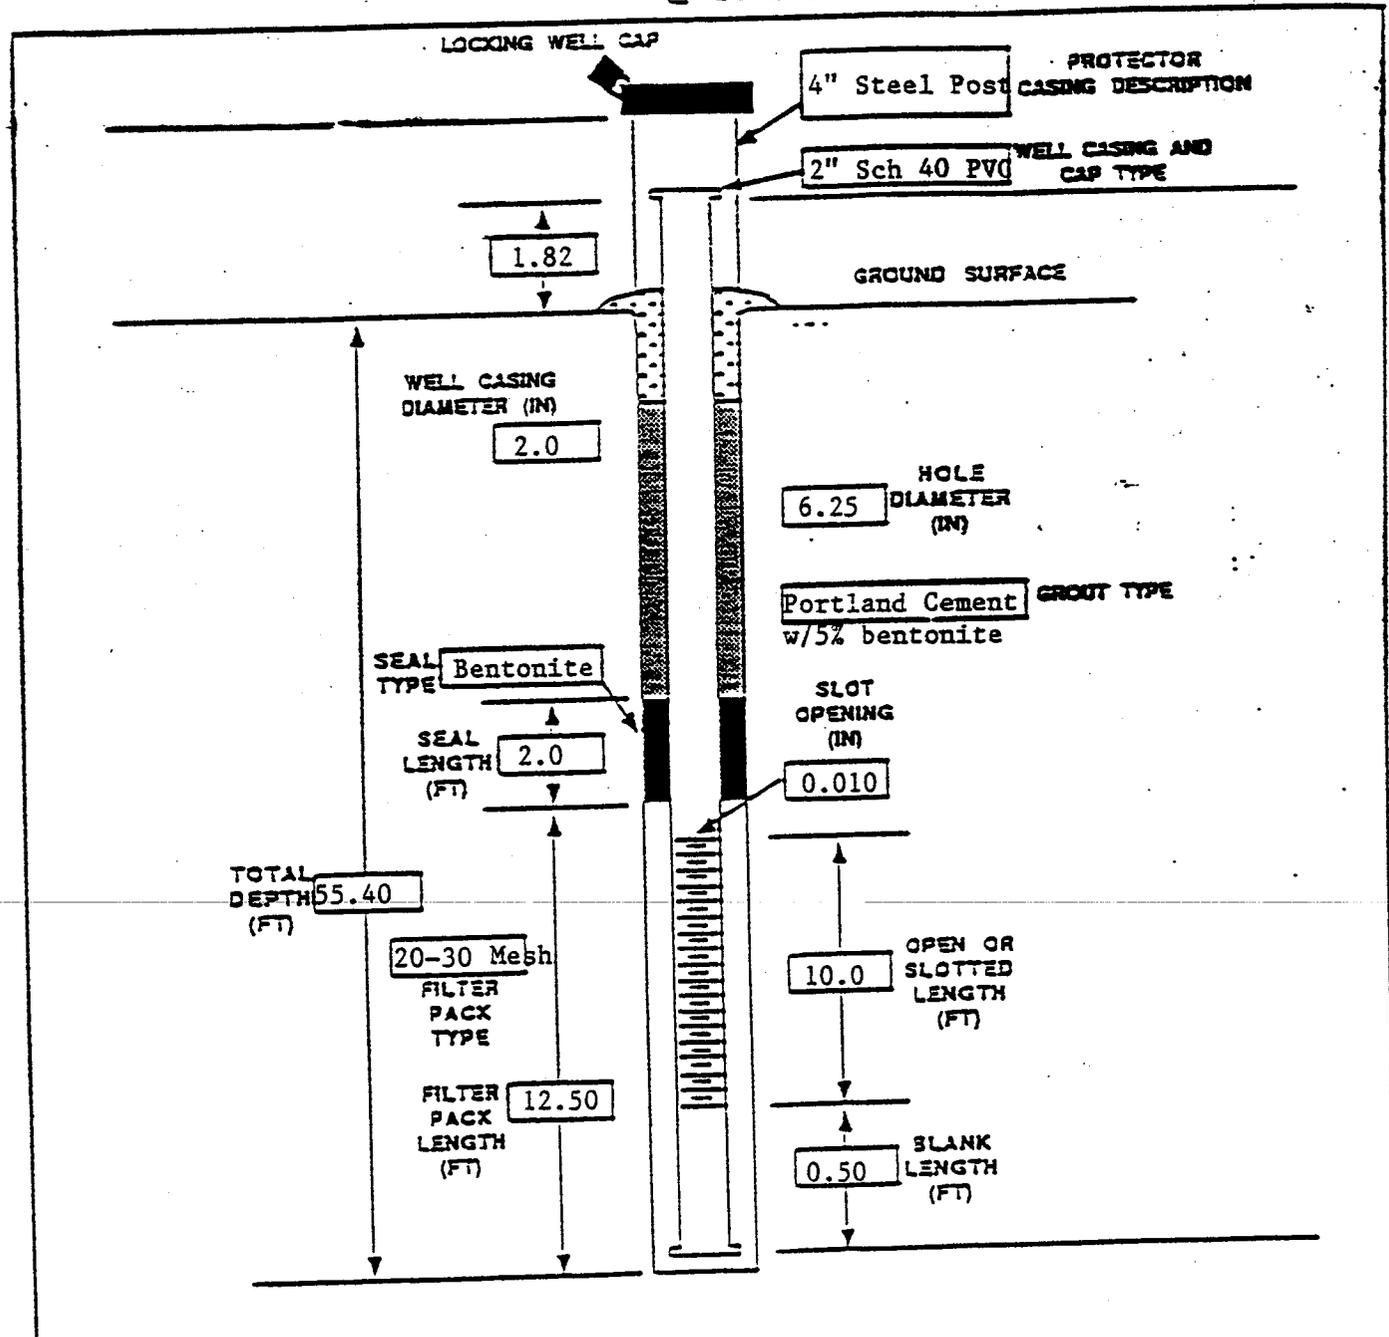


COMMENTS: Well was installed using mud/rotary drilling. Drilling was terminated at 55.40' when rig was unable to penetrate formation. Well was developed using a dedicated bailer.

WELL CONSTRUCTION DIAGRAM

PROJECT: The Torrington Company
 LOCATION: Sylvania, Georgia
 WELL NUMBER: B-6
 DATE INSTALLED: 12/11/90


ELEVATION: _____
 GROUND CASING PROTECTOR CASING
 ABOVE GROUND LEVEL ABOVE MEAN SEA LEVEL

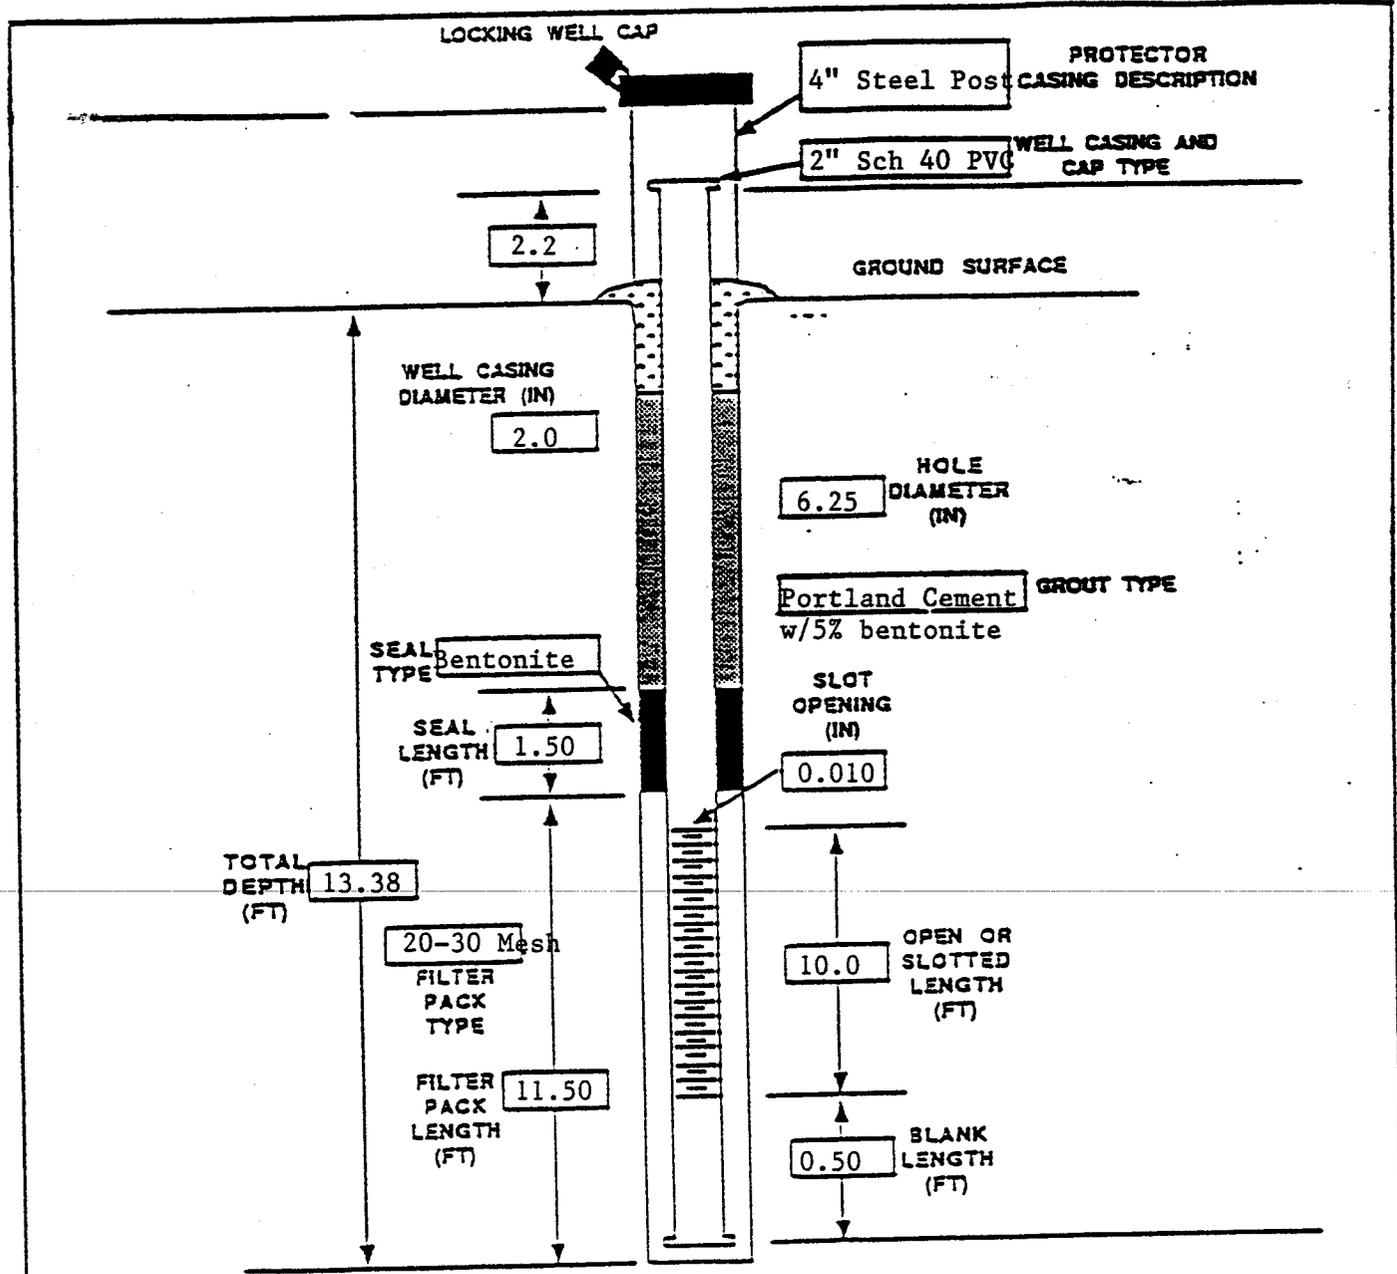

COMMENTS: Well was installed using 6.25" hollow-stem augers. After
installation well was developed using a PVC bailer.

PROJECT: Torrington
 LOCATION: Sylvania, GA
 WELL NUMBER: W-23D
 DATE INSTALLED: March 22-23, 1988

ELEVATION: 177.8 Ft. AMSL
 GROUND CASING PROTECTOR CASING
 ABOVE GROUND LEVEL ABOVE MEAN SEA LEVEL

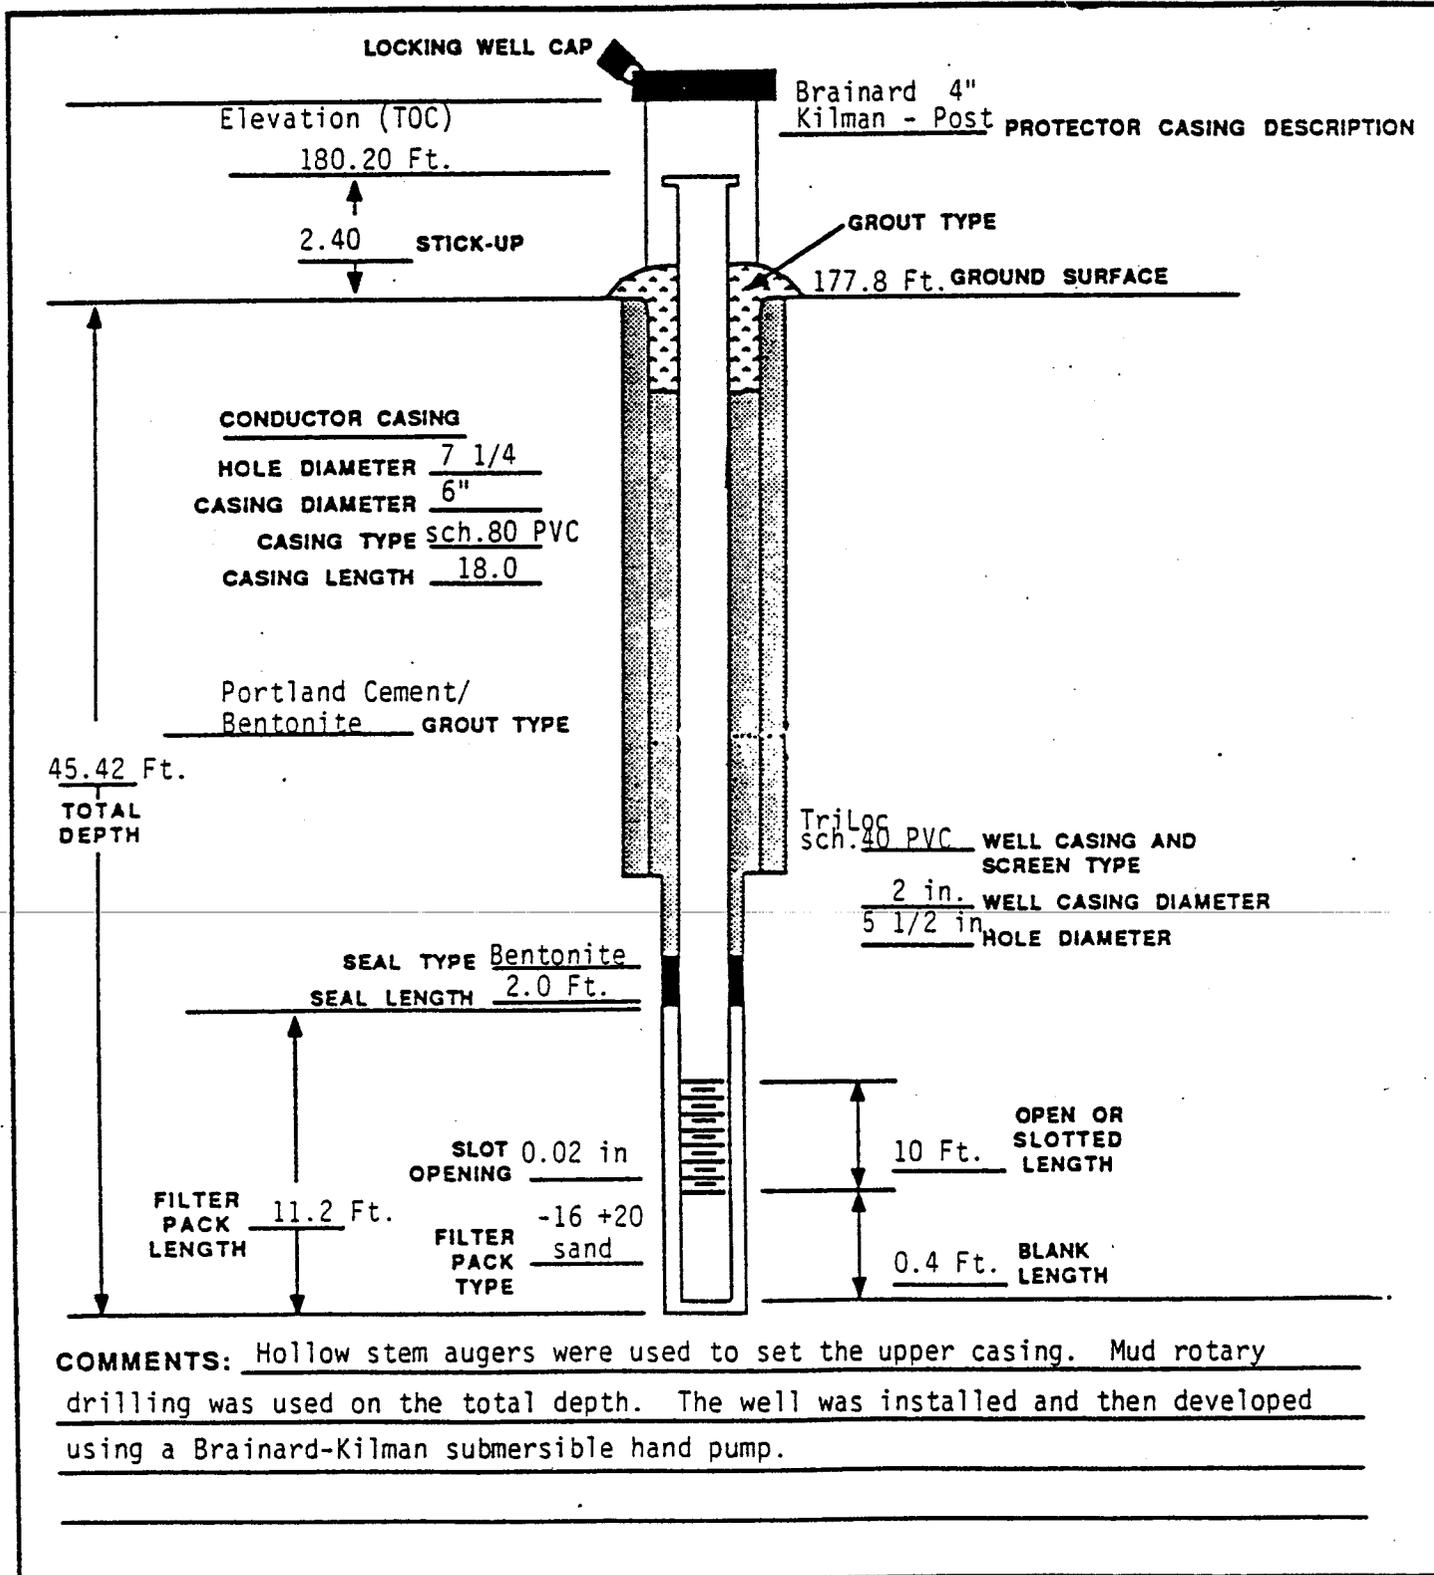


COMMENTS: Hollow stem augers were used to set the upper casing. Mud rotary drilling was used on the total depth. The well was installed and then developed using a Brainard-Kilman submersible hand pump.

LANDFILL AREA

WELL CONSTRUCTION DIAGRAM

CLIENT The Torrington Company BORING NO. L1
 PROJECT NAME _____ JOB NO. _____ DATE 6-24-86
 PROJECT LOCATION Sylvania, GA STATION _____
 BORING METHOD _____ FOREMAN Bob Alexander (Sunrise/ATEC)
 ROCK CORE DIA. _____ in. INSPECTOR Mark A. Potts (SSA)
 SHELBY TUBE O.D. _____ in.

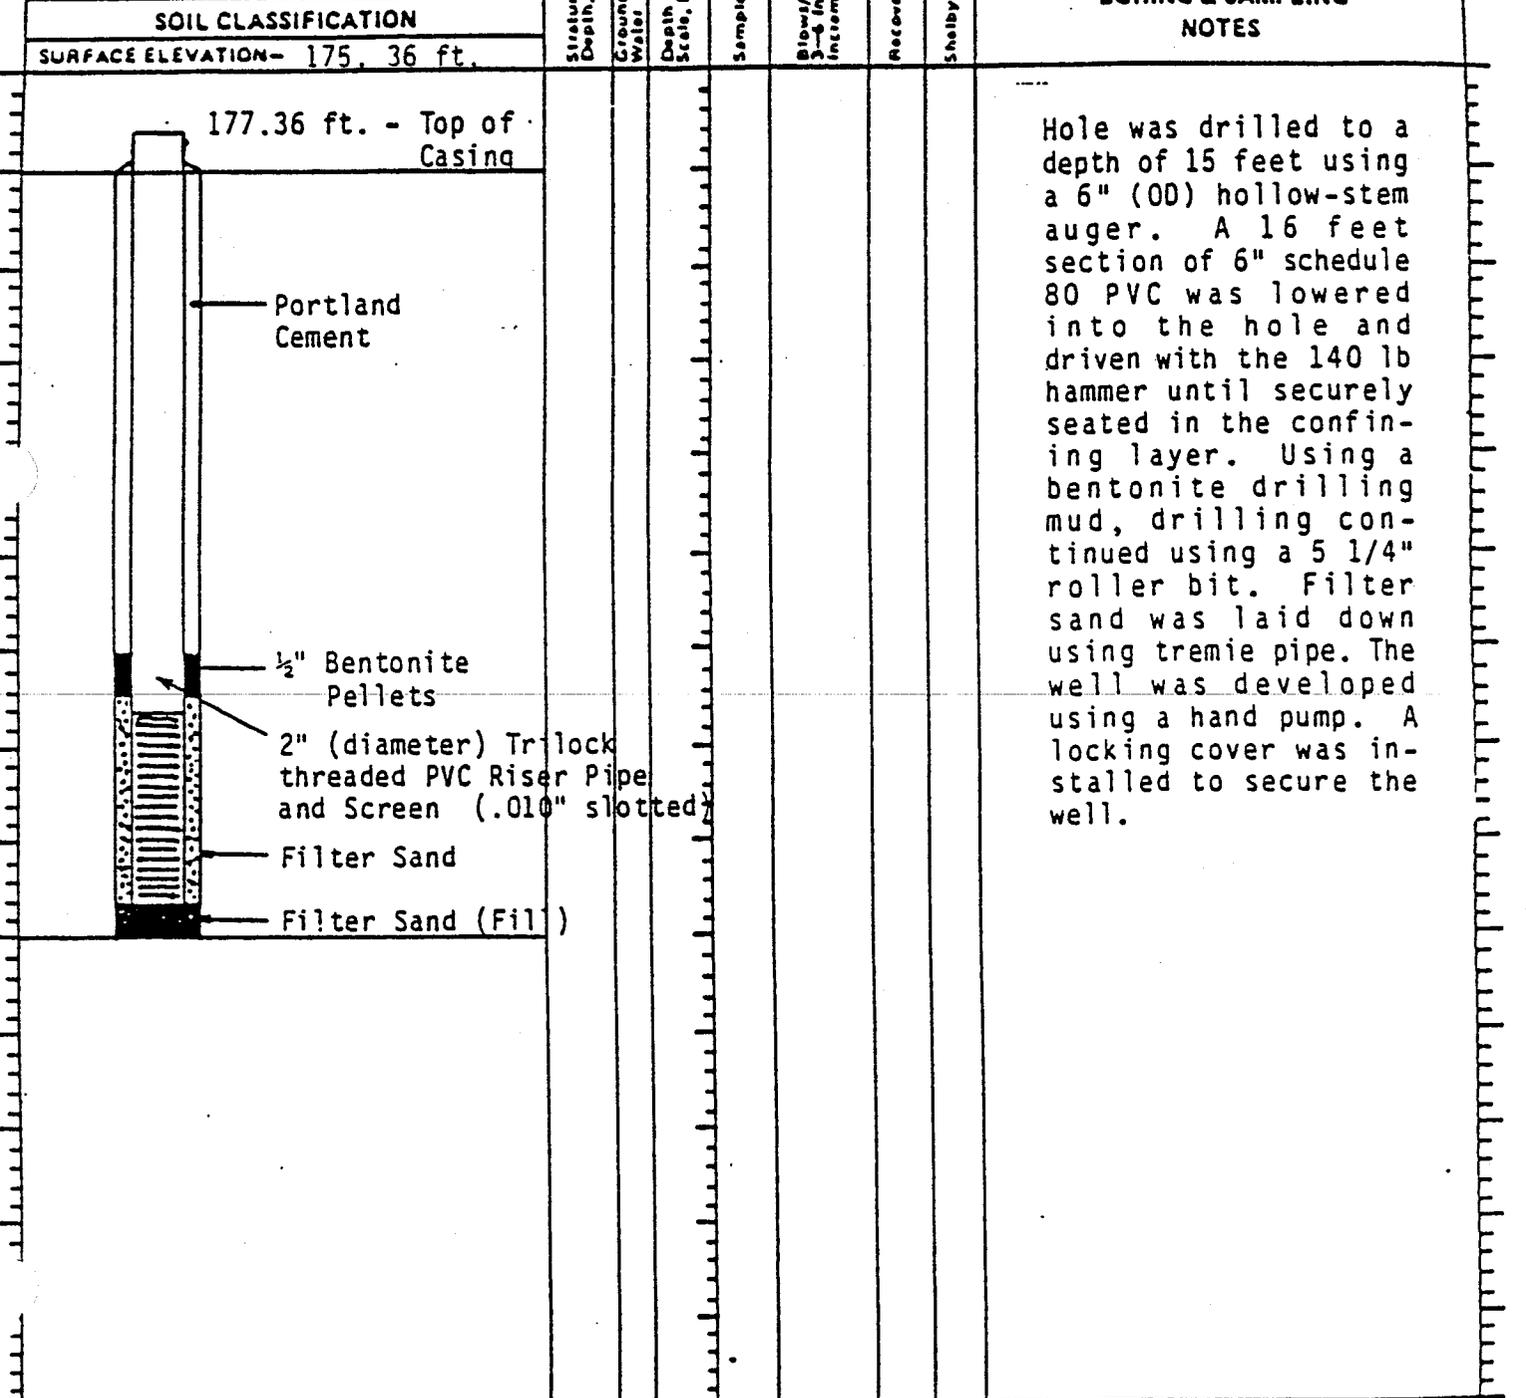

BORING METHOD
 HSA - HOLLOW STEM AUGER
 CFA - CONTINUOUS FLIGHT AUGER
 DC - DRIVEN CASING
 MD - MUD DRILLING

GROUND WATER
 NOTED ON RODS _____ FT.
 AT COMPLETION _____ FT.
 _____ FT.

*THESE SHELBY TUBE SAMPLES OBTAINED IN BORING _____ DRILLED A FEW FEET FROM BORING _____

**STANDARD PENETRATION TEST

RECORD OF SOIL EXPLORATION

Sheet No. 1 of 2

CLIENT The Torrington Company BORING NO. LI (Landfill)
 PROJECT NAME _____ JOB NO. _____ DATE 6-24-86
 PROJECT LOCATION Sylvania, GA STATION _____
 BORING METHOD Mud Rotary Drill, 5 1/2" Roller Bit SPT **
 ROCK CORE DIA. _____ FOREMAN Bob Alexander (Sunrise/Atec)
 SHELBY TUBE O.D. _____ INSPECTOR Mark A. Potts (SSA)

SOIL CLASSIFICATION	Stratum Depth, Ft.	Ground Water	Depth Scale, Ft.	Sample No.	Blows/6 in. Increments	Recovery, %	Shelby Tube No.	BORING & SAMPLING NOTES
SURFACE ELEVATION - <u>175.36 ft.</u>			0					yellow-brown clayey medium SAND, very dense at surface (SC)
			5	1	12 10 8			medium compact mottled yellow-brown clayey medium to fine SAND (SC)
			10	2	6 7 8			medium compact mottled reddish-brown clayey medium to fine SAND (SC)
	14.2		15	3	7 6 9			stiff greenish gray CLAY w/ purple mottling, trace sand (CH)
			20	4	5 7 14			very stiff greenish gray CLAY with purple mottling, sandy layer at 18.5' (CH)
	27		25	5	7 9 12			very stiff greenish gray CLAY, sandy (CH)
			30	6	5 7 11			medium compact yellow-brown laminated fine SAND, clayey at top (SP)

- BORING METHOD**
 HSA - HOLLOW STEM AUGER
 CFA - CONTINUOUS FLIGHT AUGER
 DC - DRIVEN CASING
 MD - MUD DRILLING
 RC - ROCK CORING

GROUND WATER

NOTED ON RODS _____ FT.
 AT COMPLETION _____ FT.
 AFTER _____ HRS. _____ FT.

*THESE SHELBY TUBE SAMPLES OBTAINED IN BORING _____ DRILLED A FEW FEET FROM BORING _____
 **STANDARD PENETRATION TEST

RECORD OF SOIL EXPLORATION

Sheet No. 2 of 2

CLIENT The Torrington Company BORING NO. L1 (Landfill)

PROJECT NAME _____ JOB NO. _____ DATE 6-24-86

PROJECT LOCATION Sylvania, GA STATION _____

BORING METHOD Mud Rotary Drill, 5 1/2" Roller Bit SPT **

ROCK CORE DIA. _____ in. FOREMAN Bob Alexander (Sunrise/ATEC)

SHELBY TUBE O.D. _____ in. INSPECTOR Mark A. Potts (SSA)

SOIL CLASSIFICATION
SURFACE ELEVATION - 175.36 ft

Strat. Depth, Ft.	Ground Water	Depth Scale, Ft.	Sample No.	Blows/6 In. 3 1/4 In. Increments	Recovery, %	Shelby Tube No.
		35	7	4 5 9		
		40	8	3 4 7		

BORING & SAMPLING NOTES

medium compact gray laminated medium to fine SAND, clayey. purple mottling, black blebs and thin lenses of CL noted. (SC)

medium compact fine SAND, clayey. Thin lenses of CL noted. (SC)


BORING METHOD
 HSA - HOLLOW STEM AUGER
 CFA - CONTINUOUS FLIGHT AUGER
 OC - DRIVEN CASING
 MD - MUD DRILLING
 RC - ROCK CORING

GROUND WATER
 NOTED ON RODS _____ FT.
 AT COMPLETION _____ FT.
 AFTER _____ HRS. _____ FT.

*THESE SHELBY TUBE SAMPLES OBTAINED IN BORING _____ DRILLED A FEW FEET FROM BORING _____
 **STANDARD PENETRATION TEST

PROJECT: Torrington Company
 LOCATION: Sylvania, Georgia
 WELL NUMBER: I-1D
 DATE INSTALLED: November 9-11, 1988

ELEVATION: 178.65 ft AMSL (TOC)
 GROUND CASING PROTECTOR CASING
 ABOVE GROUND LEVEL ABOVE MEAN SEA LEVEL

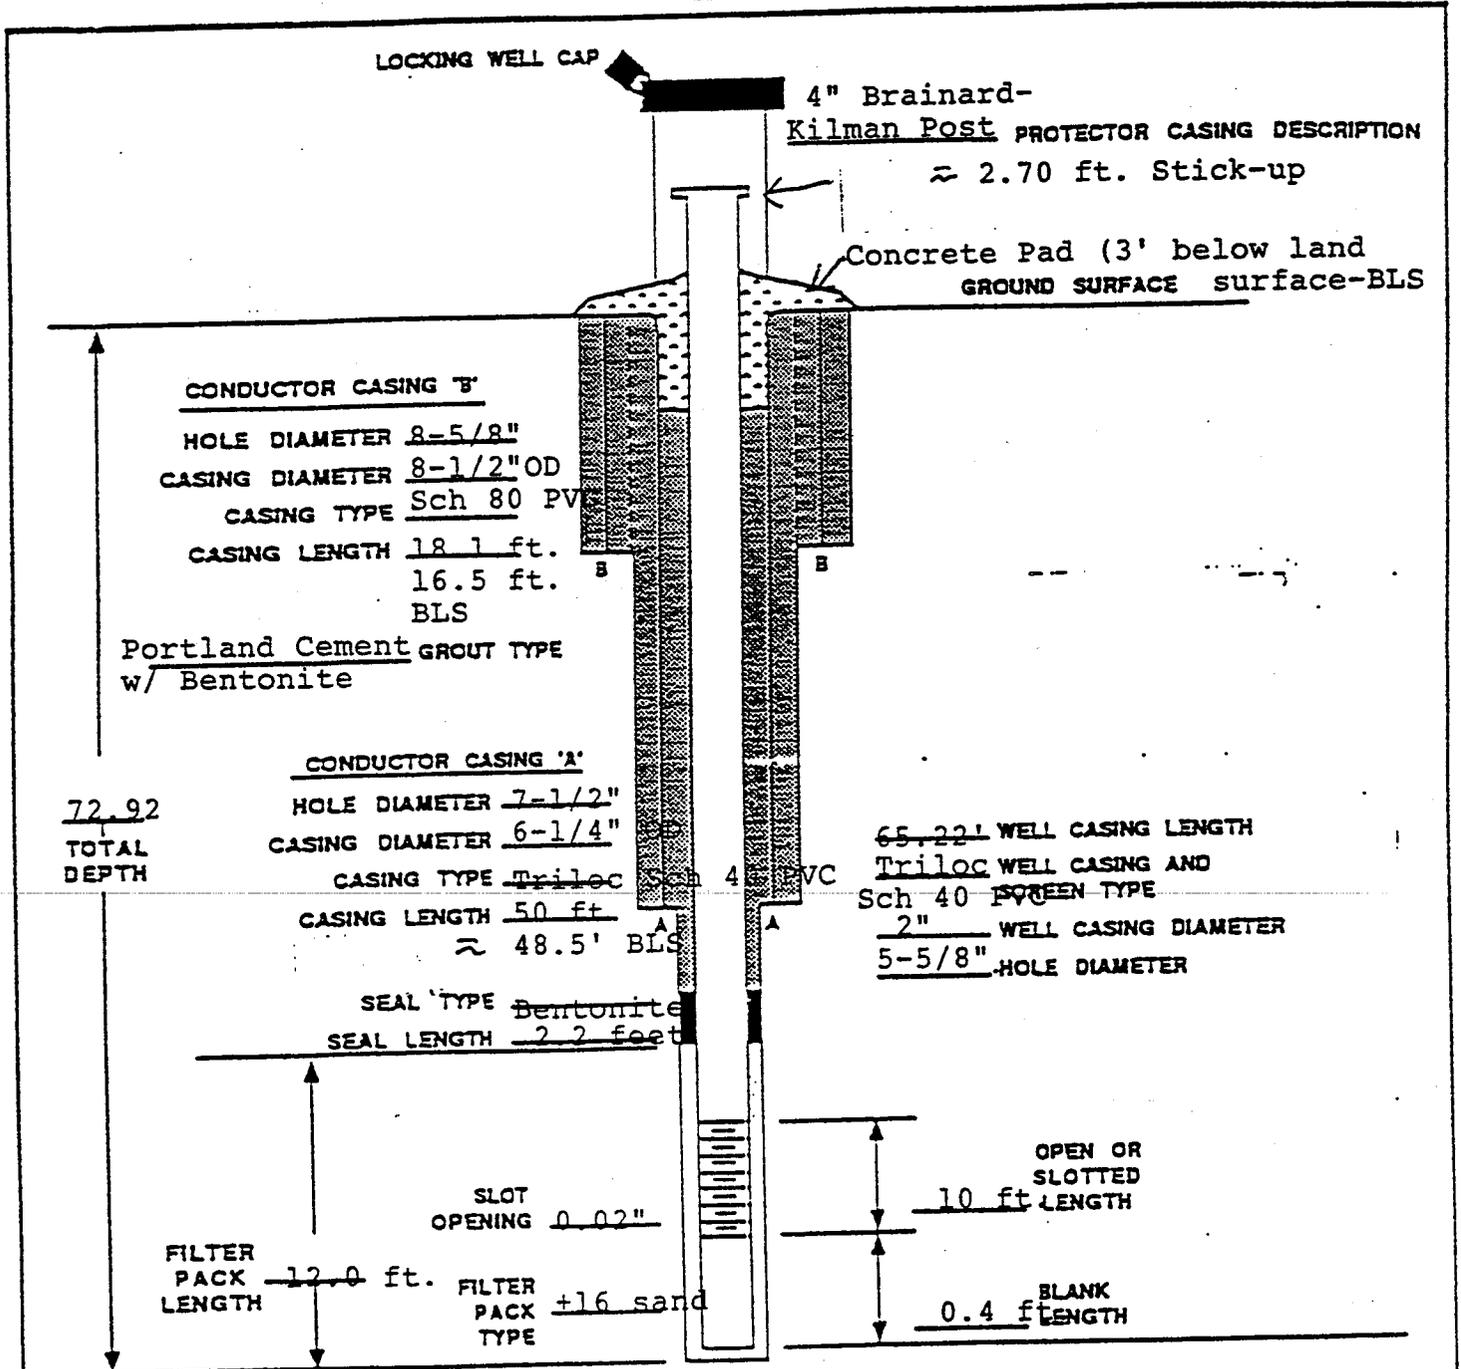

COMMENTS: The upper sand section was mud rotated and set. The second casing was set to a depth of within 48.5 ft below land surface. Twenty feet of bentonite grout (volclay) sealed the hole on the bottom. Well was drilled to total depth using hand drilling. All water and mud was excavated between steps of all equipment was decontaminated. Volclay was allowed to set at least 12 hrs. (Greater than 8 hrs. recommended.)

Atlanta Environmental Management Inc.
Monitoring Well Log


Date: November 14-16, 1988

Owner: Torrington Co Screened From: _____ ft. to _____ ft.
 Well No: L-1D Gravel Pack: _____ mesh to _____ ft.
 Location: Sylvania, Ga Bentonite Seal: _____ ft. to _____ ft.
Landfill Concrete Seal from _____ ft. to surface
 Driller: P. Clawson (Geothermics) Water Level: 50.25 ft. below well top. (12/14/88)
 Geologist: M. Potts Well top elevation: 178.65 AMSL ft. (TOC)
 Drilling Method: HSA/Mud Rotary

Depth (feet) From	To	Lithology	Remarks
0	30 ft.	See well log for monitoring well L-1 logging for this well began at 40 ft.	
		SM-Light yellowish gray silty fine to medium sand. Fines 5-10% Moderately well sorted (SM)	Sample #1 34-35.5
		Light greenish gray color silty fine to medium sand approx 1% mafic minerals (SM)	Sample #2 39-40.5
		Light greenish gray very poorly sorted clayey fine to medium sand approx 5-10% clay. 5-10% Very coarse sand - fine gravel (SC)	Sample #3 44-45.5
		Light gray silty fine sand, very well sorted approx 5% fines. (SM)	Sample #4 49-50.5
		Light greenish gray clayey poorly sorted, fine to medium sand approx. 10-15% clay. Very dry. Hard minor staining (SC)	Sample #5 54-54.5
	57	Green fat clay with interbedded fine clayey sand 80% C4	
57		20% SC Stiff Hard (CH)	Sample #6 59-60.5
	65	Greenish gray stiff fat clay with intermixed fine sand approx 10% dry. (CH)	Sample #7 64.5-65
65		Light greenish gray moderately well sorted fine to medium sand,	Sample #8 65-65.5

RECORD OF SOIL EXPLORATION

CLIENT The Torrington Company BORING NO. LF-3
 PROJECT NAME Phase I Groundwater Assessment JOB NO. _____ DATE 3/21/8
 PROJECT LOCATION Sylvania, GA. STATION Landfill Area
 BORING METHOD 5" I.D. Hand Auger (Stainless) FOREMAN Mike Sheehan
 ROCK CORE DIA. _____ in. INSPECTOR Mark Potts
 SHELBY TUBE O.D. _____ in.

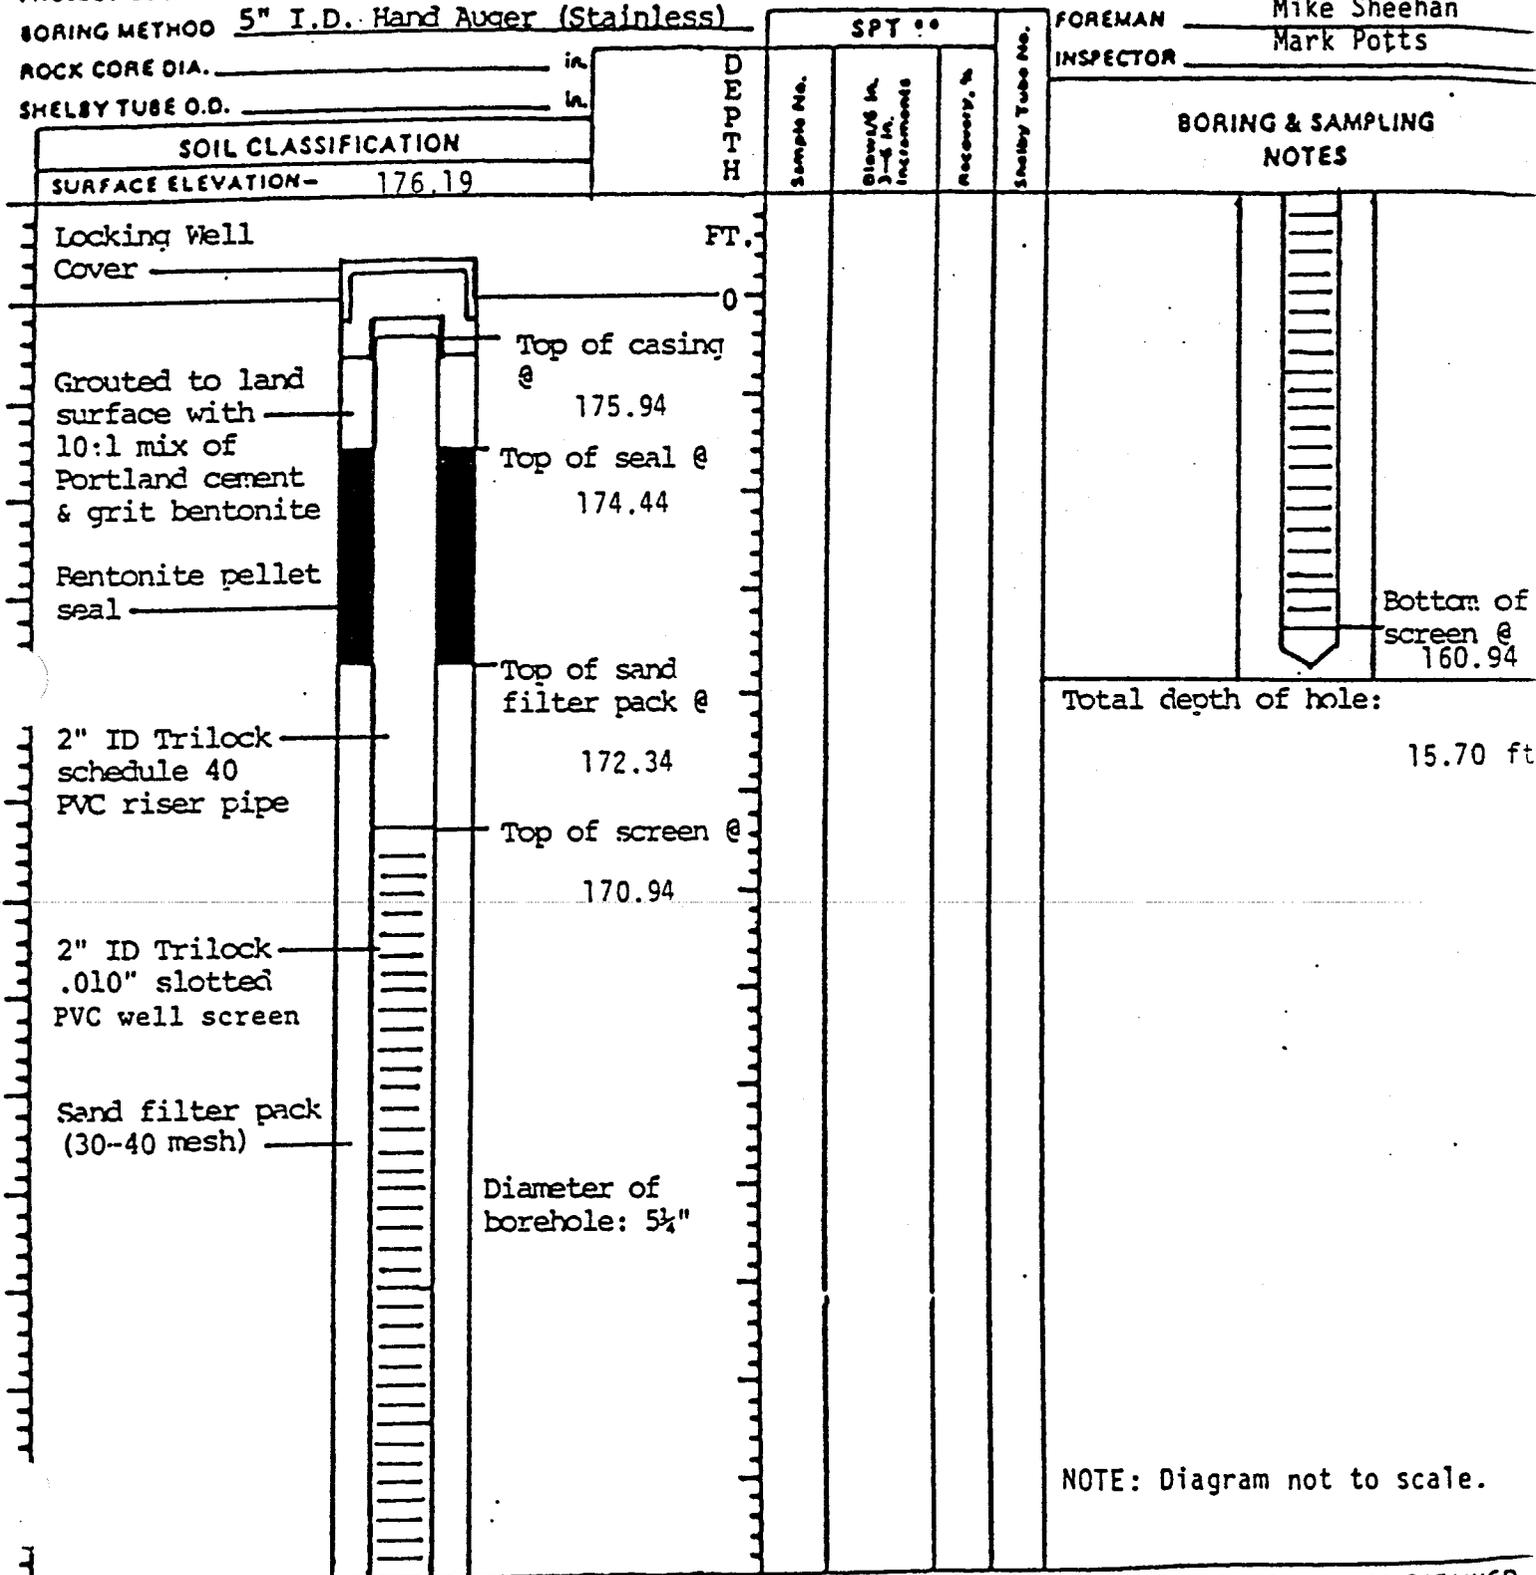

NOTE: Diagram not to scale.

BORING METHOD
 HSA - HOLLOW STEM AUGER
 CFA - CONTINUOUS FLIGHT AUGER
 DC - DRIVEN CASING
 MO - MUD DRILLING

GROUND WATER
 ▽ NOTED ON ROGS _____ FT.
 ▽ AT COMPLETION _____ FT.
 ▽ AFTER _____ HRS. _____ FT.

*THESE SHELBY TUBE SAMPLES OBTAINED BORING _____ DRILLED A FEET FROM BORING _____ PENETRATION TEST

The Torrington Company

BORING NO. LF-3

NAME Phase I Groundwater Assessment

JOB NO.

DATE 3/21/87

PROJECT LOCATION Sylvania, GA.

STATION Landfill area

BORING METHOD 5" I.D. Hand Auger (Stainless)

FOREMAN Wyman Harley

INSPECTOR Michael Sheehan

ROCK CORE DIA. _____ in.
SHELBY TUBE O.D. _____ in.

DEPTH FT.	SPT **			Shelby Tube No.
	Sample No.	Blows/ft. 3-6 in. increments	Recovery, %	
0				
2				
4				
6				
8				
10				
12				

SOIL CLASSIFICATION

BORING & SAMPLING NOTES

SURFACE ELEVATION - 176.19

FT.

12

(0-1.0) Light gray-brown, well sorted, fine gr., quartz sand with minor silt. Minor organic matter. Possibly fill.

14

(1.0-3.0) Light gray-brown, well sorted, fine gr., quartz sand, approx. 15% silt.

(14.8-15.5) Compentent, dark maroon and gray, fat clay.

16

(3.0-8.0) Orange-brown, moderately sorted, fine to medium gr., quartz sand. Approx. 30% silt/clay.

Note: At approx. 9.0 ft., bore hole walls began to collapse. Cased 0-10.0 ft. with 4" I.D. PVC pipe. Remainder of hole bored with 3.25" I.D. hand auger.

Rational for discontinuing hole: CH horizon intersected.

Total Depth: 15.5

- BORING METHOD
- HSA - HOLLOW STEM AUGER
 - CFA - CONTINUOUS FLIGHT AUGER
 - OC - DRIVEN CASING
 - MO - MUD DRILLING
 - AC - ROCK CORING


- GROUND WATER
- ▽ NOTED ON RODS _____ FT.
 - ▽ AT COMPLETION _____ FT.
 - ▽ AFTER _____ HRS. _____ FT.

**THESE SHELBY TUBE SAMPLES OBTAINED IF BORING _____ DRILLED A FEW FEET FROM BORING _____

**STANDARD PENETRATION TEST

WELL CONSTRUCTION DIAGRAM

Project: Torrington Company
 Location: Sylvania, GA
 Well Number: LF-5 Ground Elevation(AMSL): 170.82
 Date Installed: 12/3/91 Casing Elevation(AMSL): 172.32
 Hole Diameter[in]: 8.25 Filter Pack Type: 20-30 mesh sand
 Well Casing Diameter[in]: 2.0 Slot Opening[in]: 0.010

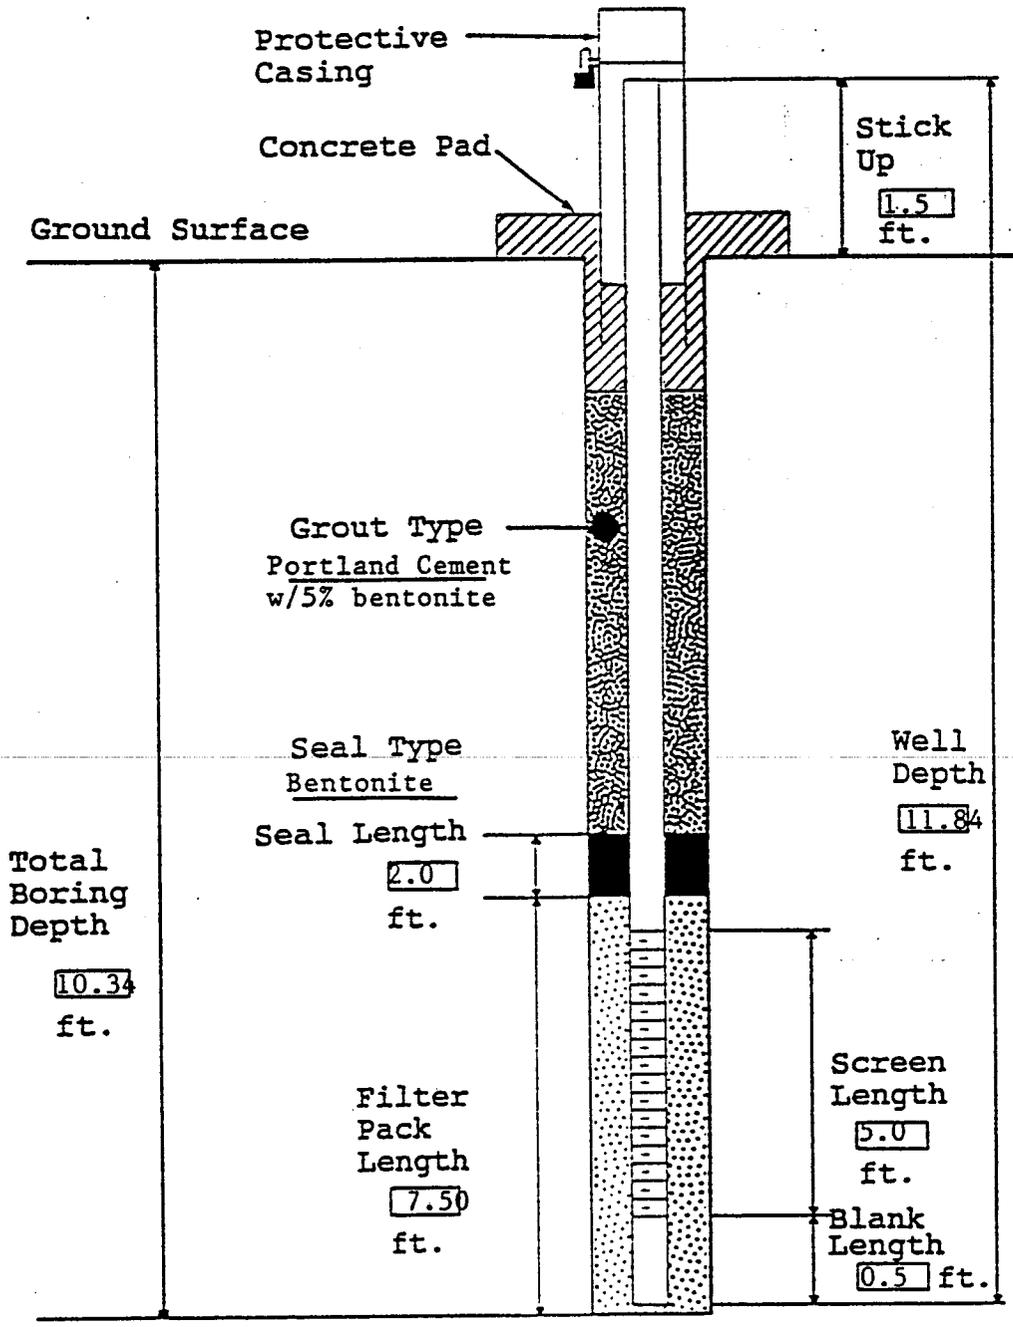


Comments: Boring was dry-a monitoring well was installed to monitor area down-gradient of proposed collection trench.

Well Development: Well was developed on 1/7/92 using a PVC bailer.

Monitoring Well DGA-1

Project: IR-Timken Remediation	Drill Rig: Geoprobe 8040 DT	Top of Casing Elevation: 185.86 ft. AMSL
Installation Date: 12/30/08	Sampler: A & E Drilling LLC	Initial Groundwater Depth: ~27.05 ft. BLS
Logged By: David Scruggs/Gerald Ingle	Hole Diameter: 6 - inch	Final Groundwater Depth: 28.78 ft. BTOC

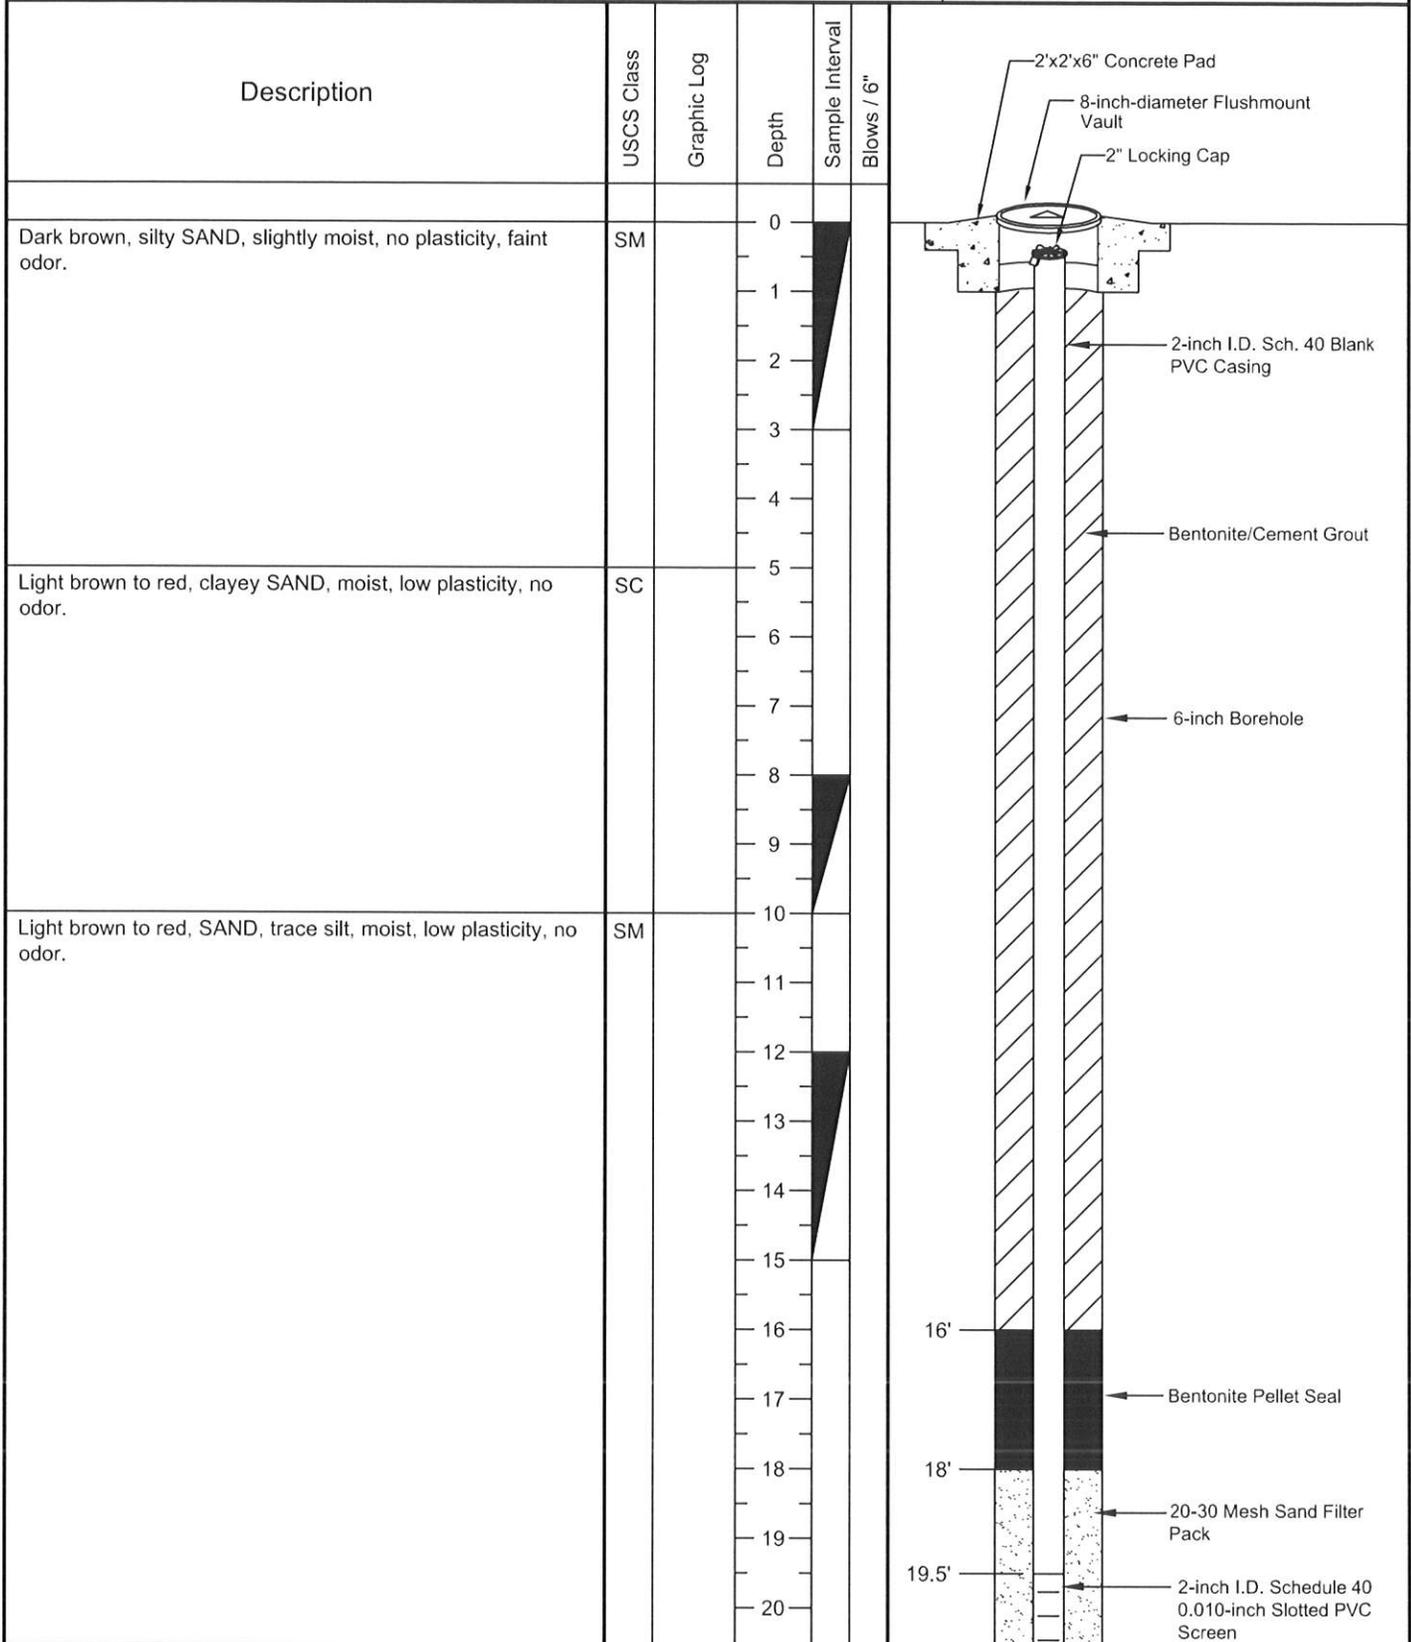

Notes:

1. USCS = Unified Soil Classification System.
2. Groundwater measured from top of casing.

Monitoring Well DGA-1

Project: IR-Timken Remediation	Drill Rig: Geoprobe 8040 DT	Top of Casing Elevation: 185.86 ft. AMSL
Installation Date: 12/30/08	Sampler: A&E Drilling LLC	Initial Groundwater Depth: ~ 27.05 ft. BLS
Logged By: David Scruggs/Gerald Ingle	Hole Diameter: 6-inch	Final Groundwater Depth: 28.78 ft. BTOC


Description	USCS Class	Graphic Log	Depth	Sample Interval	Blows / 6"	
Light brown to red, SAND, trace silt, moist, low plasticity, no odor.	SM		20 21 22 23 24			<p style="text-align: right;">2-inch I.D. Sch. 40 0.010-inch Slotted PVC Screen</p> <p style="text-align: right;">20-30 Mesh Sand Filter Pack</p> <p style="text-align: right;">6-inch I.D. Borehole</p> <p>29.5'</p> <p>30'</p>
Brown and white, mottled CLAY, moist at 25'.	CH/ CL		25 26 27 28			
Sand stringer, wet.	SM		29			
Purple/gray, mottled CLAY, high plasticity, damp, no odor.	CH		30			
Terminated boring.			31 32 33 34 35 36 37 38 39 40			

Notes:

1. USCS = Unified Soil Classification System.
2. Groundwater measured from top of casing.


Monitoring Well DGA-2

Project: IR-Timken Remediation	Drill Rig: Geoprobe 8040 DT	Top of Casing Elevation: 184.91 ft. AMSL
Installation Date: 12/31/08	Sampler: A & E Drilling LLC	Initial Groundwater Depth: ~17.5-18 ft. BLS
Logged By: Gerald Ingle	Hole Diameter: 6 - inch	Final Groundwater Depth: 16.30 ft. BTOC

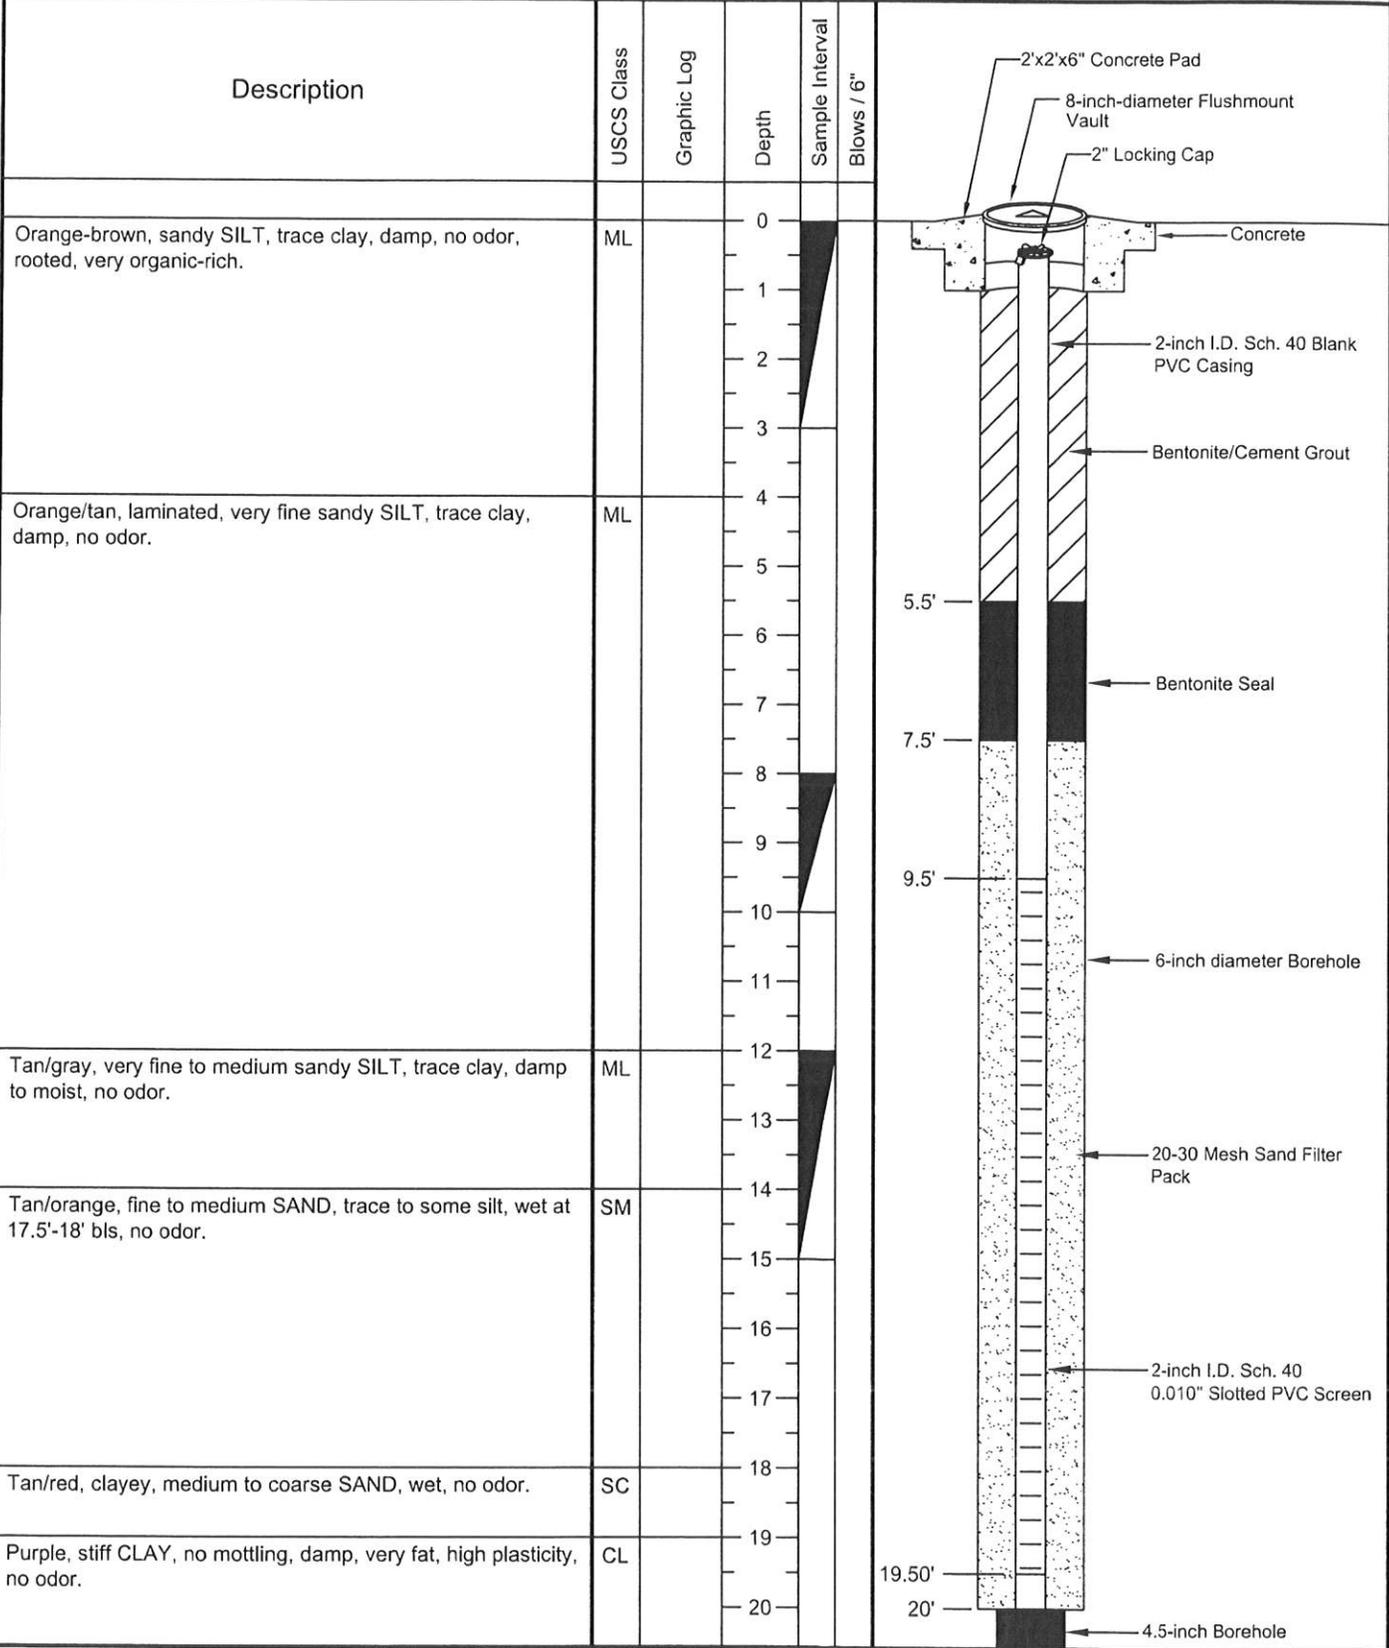


Monitoring Well DGA-2

Project: IR-Timken Remediation	Drill Rig: Geoprobe 8040 DT	Top of Casing Elevation: 184.91 ft. AMSL
Installation Date: 12/31/08	Sampler: A & E Drilling LLC	Initial Groundwater Depth: ~17.5-18 ft. BLS
Logged By: Gerald Ingle	Hole Diameter: 6 - inch	Final Groundwater Depth: 16.30 ft. BTOC

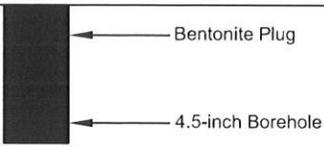Description	USCS Class	Graphic Log	Depth	Sample Interval	Blows / 6"	
Orange/tan, fine to medium SAND, trace clay, dry to damp, no odor	SP		20			
Pink/tan, fine to medium SAND, dry, no odor.	SP		21			
Terminated boring.			22			
			23			
			24			
			25			
Monitoring Well DGA-3

Project: IR-Timken Remediation	Drill Rig: Geoprobe 8040 DT	Top of Casing Elevation: 186.51 ft. AMSL
Installation Date: 12/29/08	Sampler: A & E Drilling LLC	Initial Groundwater Depth: ~22 ft. BLS
Logged By: David Scruggs	Hole Diameter: 6 - inch	Final Groundwater Depth: 19.02 ft. BTOC

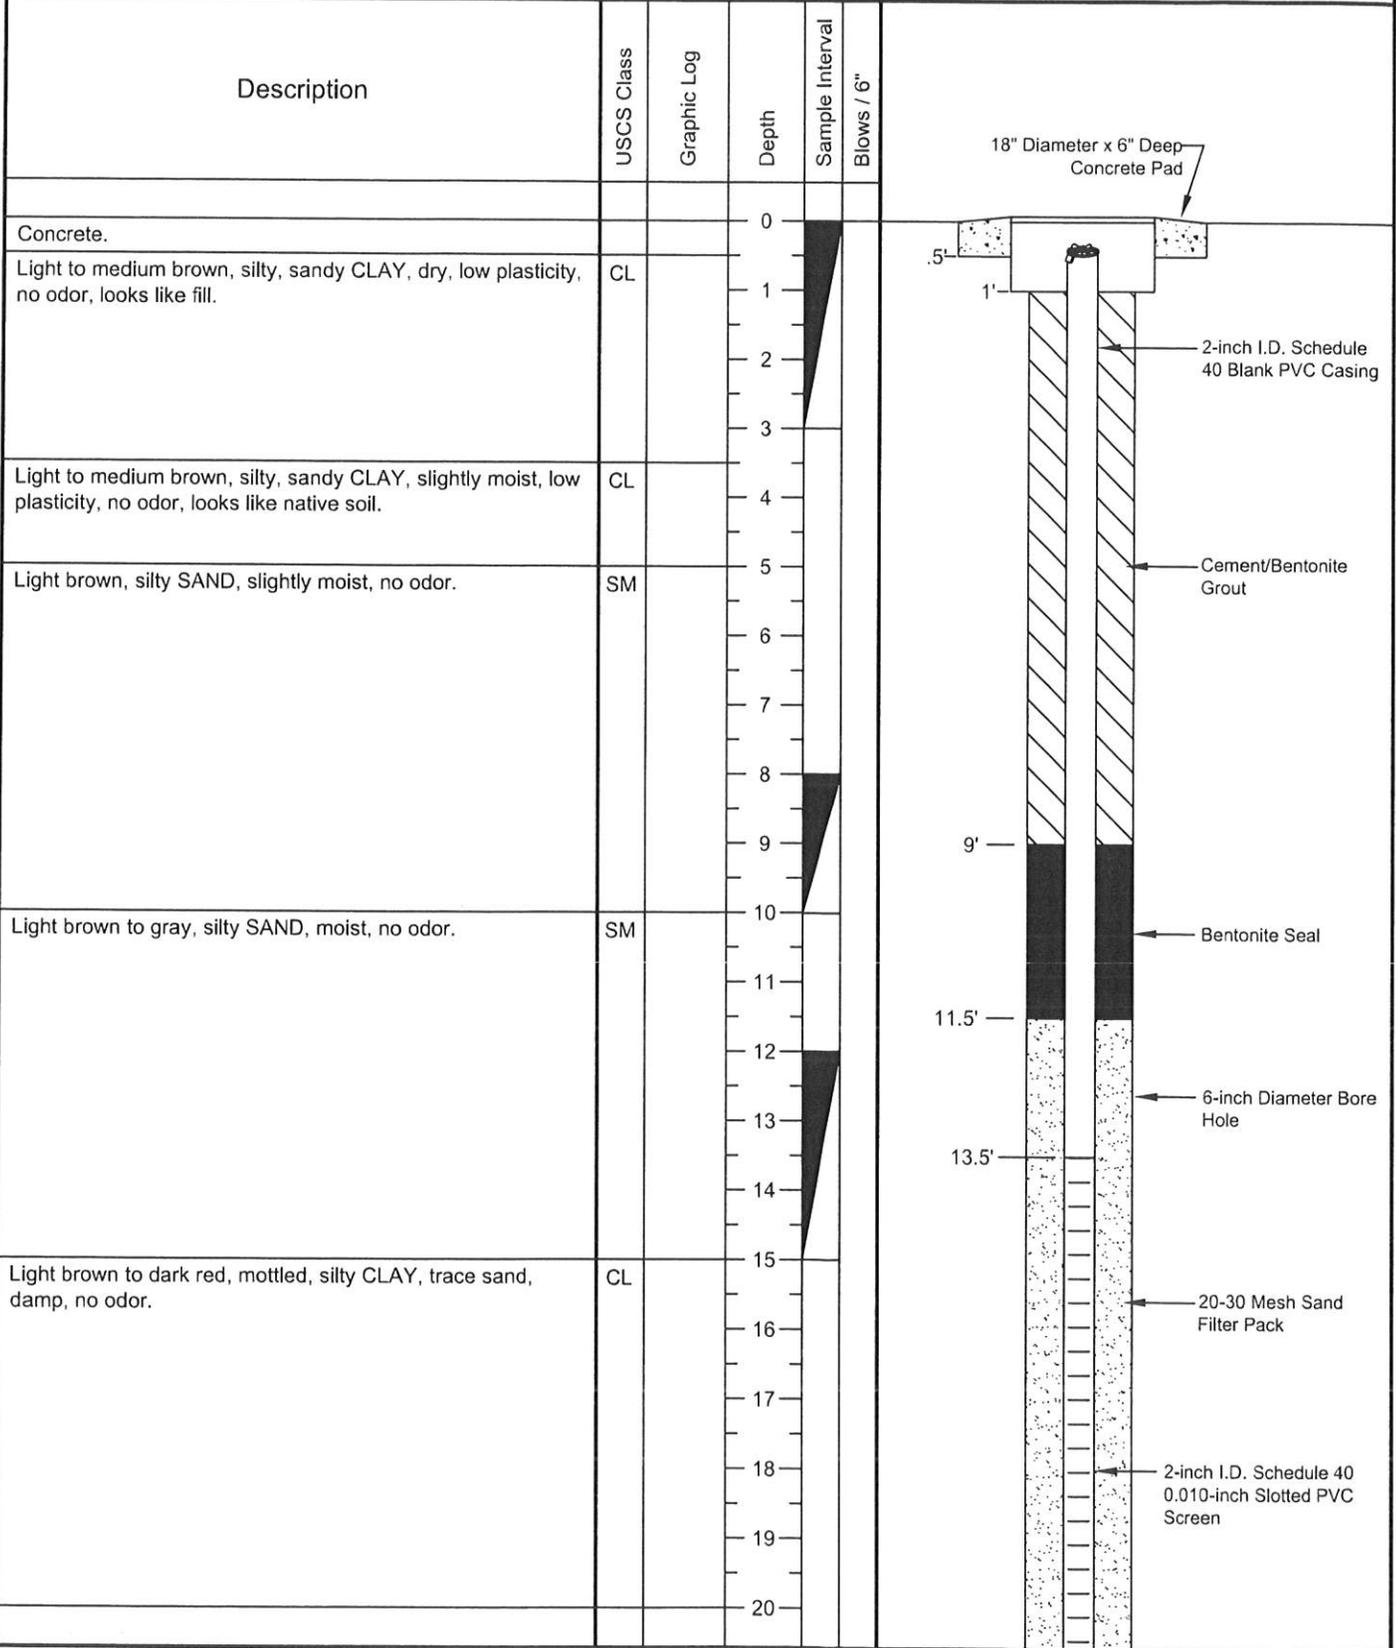

2580 Northeast Expressway • Atlanta Georgia 30345
 Telephone: (404) 329-9006 • Fax: (404) 329-2057

Notes:
 1. USCS = Unified Soil Classification System.
 2. Groundwater measured from top of casing.

Project No.
1162-0901-6

Monitoring Well DGA-3

Project: IR-Timken Remediation	Drill Rig: Geoprobe 8040 DT	Top of Casing Elevation: 186.51 ft. AMSL
Installation Date: 12/29/08	Sampler: A & E Drilling LLC	Initial Groundwater Depth: ~22 ft. BLS
Logged By: David Scruggs	Hole Diameter: 6 - inch	Final Groundwater Depth: 19.02 ft. BTOC

Description	USCS Class	Graphic Log	Depth	Sample Interval	Blows / 6"	
Gray, clayey SILT, trace sand, low plasticity, 1-inch thick wet sand stringer at 22.5 feet, rest of interval damp.	CL/ SP		20 21 22 23 24			
Terminated Boring.			25 26 27 28 29 30 31 32 33 34 35 36 37 38 39 40			

Monitoring Well DGA-4D

Project: IR-Timken Remediation	Drill Rig: Geoprobe 8040 DT	Top of Casing Elevation: 186.55 ft. AMSL
Installation Date: 12/22/08	Sampler: A & E Drilling LLC	Initial Groundwater Depth: ~43 ft. BLS
Logged By: David Scruggs	Hole Diameter: 12-inch/6 - inch	Final Groundwater Depth: 44.85 ft. BTOC

Description	USCS Class	Graphic Log	Depth	Sample Interval	Blows / 6"	Diagram
Loose SILT and SAND, dry, no odor.	SM		0 1 2 3 4			
Light brown, silty SAND, no plasticity, dry, no odor.	SM		5 6 7 8 9 10			
Gray, silty CLAY.	CL		11			
Same as 5'-10.5'.	SM		12 13 14			
Light brown, silty SAND, slightly moist, low plasticity, old solvent odor.	SM		15 16 17 18			
Dark brown and gray, mottled CLAY, high plasticity, no odor.	CL		19 20			



2580 Northeast Expressway • Atlanta Georgia 30345
 Telephone: (404) 329-9006 • Fax: (404) 329-2057

Notes:
 1. USCS = Unified Soil Classification System.
 2. Groundwater measured from top of casing.

Project No.
1162-0901-6

Monitoring Well DGA-4D

Project: IR-Timken Remediation	Drill Rig: Geoprobe 8040 DT	Top of Casing Elevation: 186.55 ft. AMSL
Installation Date: 12/22/08	Sampler: A & E Drilling LLC	Initial Groundwater Depth: ~43 ft. BLS
Logged By: David Scruggs	Hole Diameter: 12-inch/6 - inch	Final Groundwater Depth: 44.85 ft. BTOC

Description	USCS Class	Graphic Log	Depth	Sample Interval	Blows / 6"	
No recovery.			20			<p style="font-size: small;">6-inch Diameter Borehole</p> <p style="font-size: small;">2-inch I.D. Schedule 40 Blank PVC Casing</p> <p style="font-size: small;">Cement/Bentonite Grout</p> <p style="font-size: small;">Bentonite Seal</p> <p style="font-size: small;">20-30 Mesh Sand Filter Pack</p> <p style="font-size: small;">2-inch I.D. Schedule 40 0.010-inch Slotted PVC Screen</p>
Light brown, CLAY, high plasticity, slightly moist, no odor.	CL		22			
Dark brown/red, silty SAND, dry, no odor.	SM		25			
Dark brown/red CLAY, high plasticity, slightly moist.	CL		26			
Gray, silty CLAY, high plasticity, slightly moist, no odor.	CL		29			
Light gray, clayey, sandy SILT, high plasticity, slightly moist, no odor.	ML		34			
Light brown/green, silty, sandy CLAY, high plasticity, slightly moist, no odor.	CL		38			



2580 Northeast Expressway • Atlanta Georgia 30345
 Telephone: (404) 329-9006 • Fax: (404) 329-2057

Notes:

1. USCS = Unified Soil Classification System.
2. Groundwater measured from top of casing.

Project No.
1162-0901-6

Monitoring Well DGA-4D

Project: IR-Timken Remediation	Drill Rig: Geoprobe 8040 DT	Top of Casing Elevation: 186.55 ft. AMSL
Installation Date: 12/22/08	Sampler: A & E Drilling LLC	Initial Groundwater Depth: ~43 ft. BLS
Logged By: David Scruggs	Hole Diameter: 12-inch/6 - inch	Final Groundwater Depth: 44.85 ft. BTOC

Description	USCS Class	Graphic Log	Depth	Sample Interval	Blows / 6"	
Light brown/green, silty, sandy CLAY, high plasticity, slightly moist, no odor.	CL		40			
Medium brown to gray, SAND, no plasticity, slightly moist, no odor.	SP		41			
Light brown SAND, trace silt, no plasticity, wet at 43 feet, no odor.	SM		42			
			43			
			44			
No recovery.			45			
			46			
Terminated Boring.			47			
			48			
			49			
			49.5'			
			50			
			51			
			52			
			53			
			54			
			55			

Notes:

1. USCS = Unified Soil Classification System.
2. Groundwater measured from top of casing.

Monitoring Well DGA-4D

Project: IR-Timken Remediation	Drill Rig: Geoprobe 8040 DT	Top of Casing Elevation: 186.55 ft. AMSL
Installation Date: 12/22/08	Sampler: A & E Drilling LLC	Initial Groundwater Depth: ~43 ft. BLS
Logged By: David Scruggs	Hole Diameter: 12-inch/6 - inch	Final Groundwater Depth: 44.85 ft. BTOC

Description	USCS Class	Graphic Log	Depth	Sample Interval	Blows / 6"	
Light brown/green, silty, sandy CLAY, high plasticity, slightly moist, no odor.	CL		40			<p style="text-align: right;">20-30 Mesh Sand Filter Pack</p> <p style="text-align: right;">6-inch Diameter Borehole</p> <p style="text-align: right;">2-inch I.D. Schedule 40 0.010-inch Slotted PVC Screen</p> <p style="text-align: right;">49'</p> <p style="text-align: right;">49.5'</p>
Medium brown to gray, SAND, no plasticity, slightly moist, no odor.	SP		41			
			42			
Light brown SAND, trace silt, no plasticity, wet at 43 feet, no odor.	SM		43			
			44			
			45			
			46			
			47			
			48			
			49			
No recovery. Terminated Boring.			50			
			51			
			52			
			53			
			54			
			55			
			56			
			57			
			58			
			59			
			60			

Monitoring Well DGA-5D

Project: IR-Timken Remediation	Drill Rig: Rotosonic	Top of Casing Elevation: 183.12 ft. AMSL
Installation Date: 4/28/2009	Sampler: 5.25-inch O.D. Sampler (20 Feet)	Initial Groundwater Depth: ~52 ft. BLS
Logged By: Gerald Ingle	Hole Diameter: 8 - inch / 6.5-inch	Final Groundwater Depth: 43.57 ft. BTOC

Description	USCS Class	Graphic Log	Depth	Sample Interval	Blows / 6"	
Tan, SAND (fill).	SW		0			
Red/orange, silty CLAY, dry, medium plasticity, no odor (fill).	CL		1			
			2			
			3			
			4			
			5			
			6			
Tan/pink/orange, very fine sandy SILT, some clay, some mottling, low to medium plasticity, dry, no odor.	ML		7			
			8			
			9			
			10			
			11			
			12			
			13			
Orange/pink, silty very fine to medium SAND, no clay, dry to damp, no odor.	SM		14			
			15			
			16			
Tan, very fine to medium SAND, trace to some SILT, dry, no odor.	SW		17			
			18			
			19			
			20			



2580 Northeast Expressway • Atlanta Georgia 30345
 Telephone: (404) 329-9006 • Fax: (404) 329-2057

Notes:

1. USCS = Unified Soil Classification System.
2. Groundwater measured from top of casing.

Project No.
1162-0901-6

Page 1 of 3

Monitoring Well DGA-5D

Project: IR-Timken Remediation	Drill Rig: Rotosonic	Top of Casing Elevation: 183.12 ft. AMSL
Installation Date: 4/28/2009	Sampler: 5.25-inch O.D. Sampler (20 Feet)	Initial Groundwater Depth: ~52 ft. BLS
Logged By: Gerald Ingle	Hole Diameter: 8 - inch / 6.5-inch	Final Groundwater Depth: 43.57 ft. BTOC

Description	USCS Class	Graphic Log	Depth	Sample Interval	Blows / 6"	
Tan, very fine to medium SAND, trace to some SILT, dry, no odor.	SW		20 21 22 23			
Purple/gray/brown, mottled, "fat" CLAY, high plasticity, damp, no odor.	CH		24 25			
Orange, silty very fine to fine SAND, dry, no odor.	SM		26 27 28 29			
Purple/red, "fat" CLAY, trace very fine sand, high plasticity, dry, no odor.	CH		30 31			
Purple/gray, mottled, clayey very fine SAND, non-plastic, damp, no odor.	SC		32 33 34			
			35 36 37 38 39 40			



2580 Northeast Expressway • Atlanta Georgia 30345
 Telephone: (404) 329-9006 • Fax: (404) 329-2057

Notes:

1. USCS = Unified Soil Classification System.
2. Groundwater measured from top of casing.

Project No.
1162-0901-6

Monitoring Well DGA-5D

Project: IR-Timken Remediation	Drill Rig: Rotosonic	Top of Casing Elevation: 183.12 ft. AMSL
Installation Date: 4/28/2009	Sampler: 5.25-inch O.D. Sampler (20 Feet)	Initial Groundwater Depth: ~52 ft. BLS
Logged By: Gerald Ingle	Hole Diameter: 8 - inch / 6.5-inch	Final Groundwater Depth: 43.57 ft. BTOC

Description	USCS Class	Graphic Log	Depth	Sample Interval	Blows / 6"	
White/olive green, very hard, compacted, silty very fine SAND, dry, no odor.	SM		40 41 42 43 44 45 46			<p style="font-size: small;"> Cement/Bentonite Grout Bentonite Seal 2-inch I.D. Schedule 40 Blank PVC Casing 2-inch I.D. Schedule 40 0.010-inch Slotted PVC Screen 6.5-inch Diameter Borehole 20-30 Mesh Sand Filter Pack </p>
White/light tan, very fine sandy CLAY, medium plasticity, wet, no odor.	SC		47 48 49 50 51			
Gray/tan, very fine to fine SAND, trace clay (mainly in thin seams), wet at 52', no odor.	SP		52 53 54 55 56 57			
Terminate Boring			58 59 60			



2580 Northeast Expressway • Atlanta Georgia 30345
 Telephone: (404) 329-9006 • Fax: (404) 329-2057

Notes:

1. USCS = Unified Soil Classification System.
2. Groundwater measured from top of casing.

Project No.
1162-0901-6

Monitoring Well DGA-6

Project: **IR-Timken Remediation**

Drill Rig: **Rotosonic**

Top of Casing Elevation: **180.34 ft. AMSL**

Installation Date: **4/29/2009**


Sampler: **5.25-inch O.D. Sampler (20-Feet)**

Initial Groundwater Depth: **~24 ft. BLS**

Logged By: **Gerald Ingle**

Hole Diameter: **6.5 - inch**

Final Groundwater Depth: **23.42 ft. BTOC**

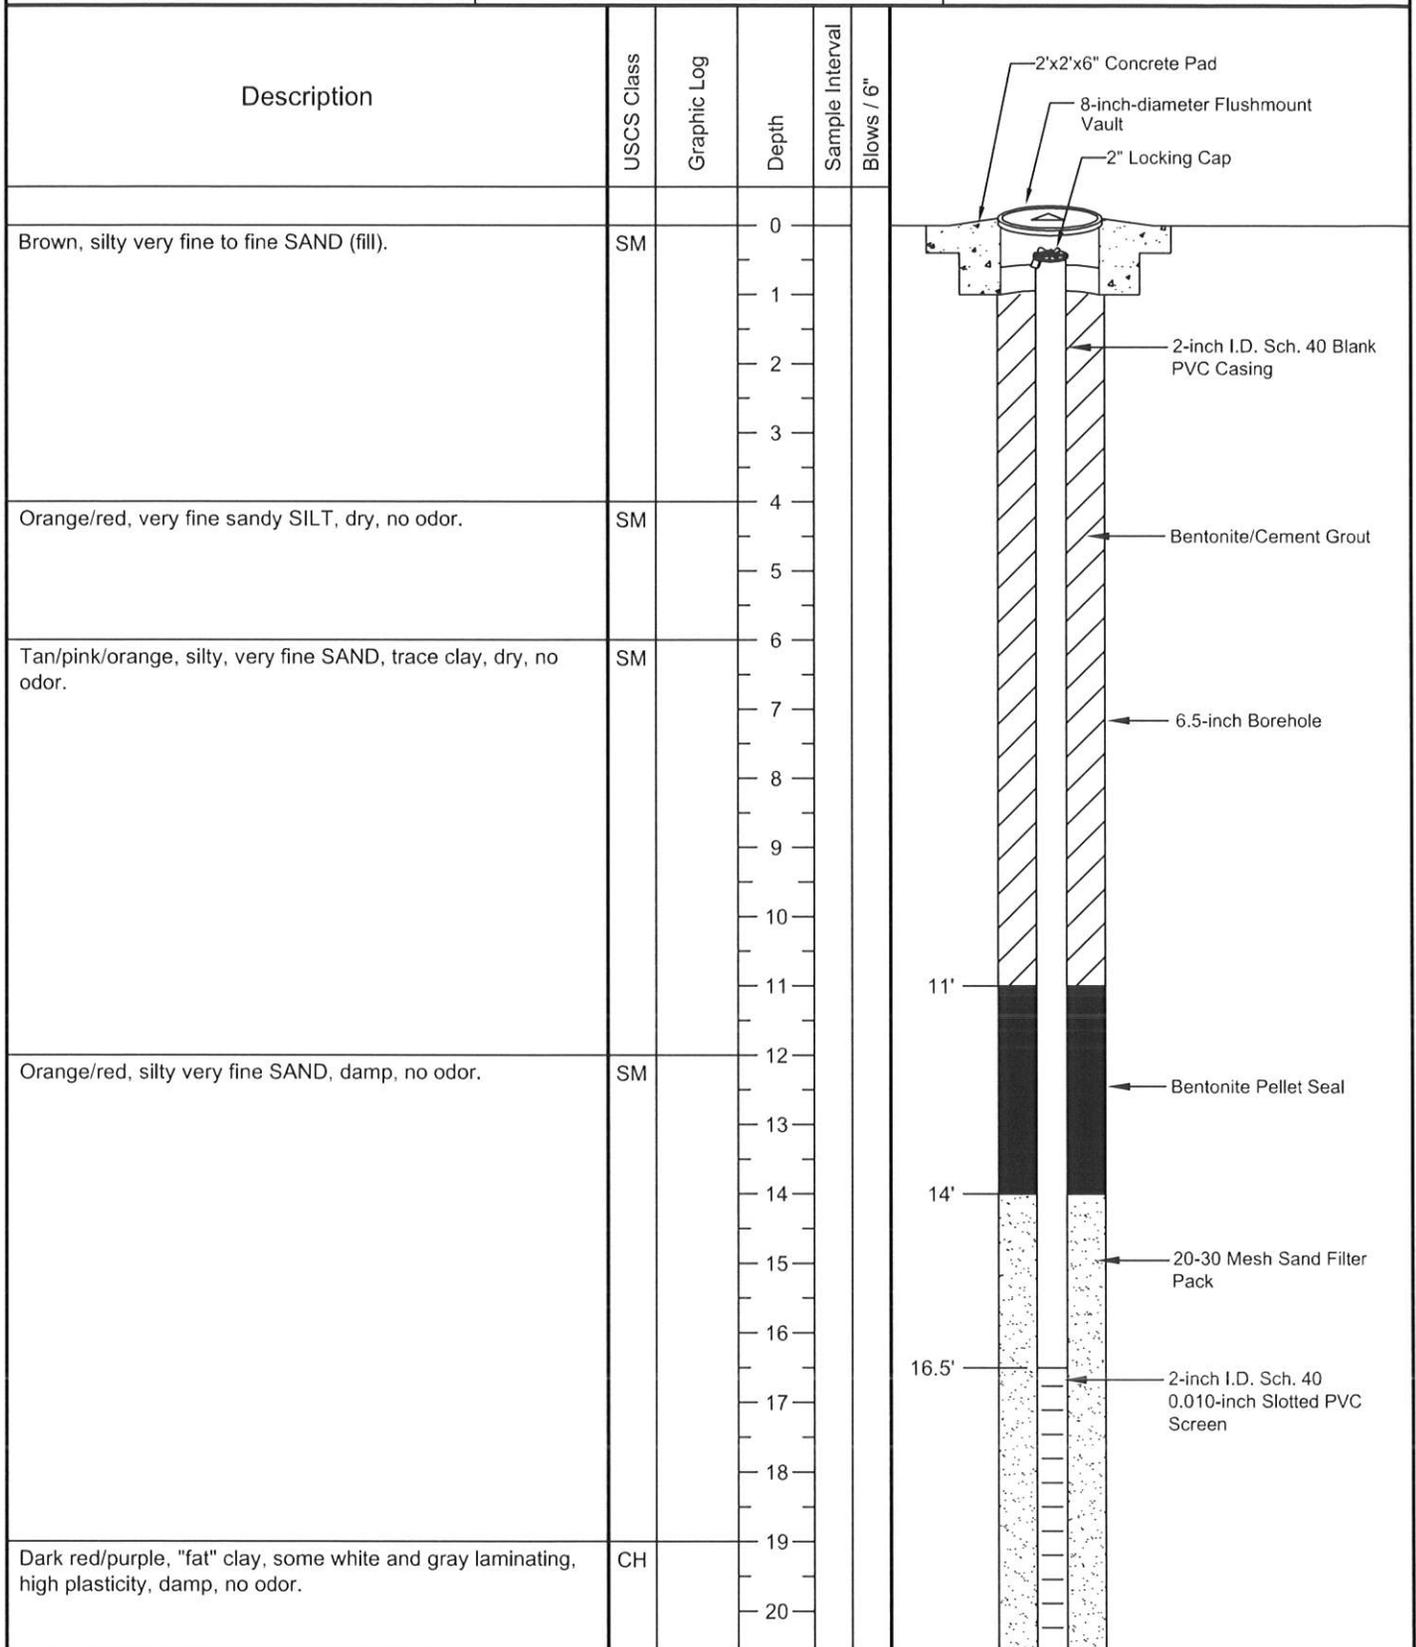

ALM Atlanta Environmental Management, Inc.
Environmental Consulting, Engineering, Hydrogeologic Services
 2580 Northeast Expressway • Atlanta Georgia 30345
 Telephone: (404) 329-9006 • Fax: (404) 329-2057

Notes:
 1. USCS = Unified Soil Classification System.
 2. Groundwater measured from top of casing.

File name: G:\DWG\1162-0901 Sylvania\06\RFI Rep\Print Date
 Print Date: 2009-06-19

Project No.
1162-0901-6
 Page 1 of 2

Monitoring Well DGA-6

Project: **IR-Timken Remediation**

Drill Rig: **Rotosonic**

Top of Casing Elevation: **180.34 ft. AMSL**

Installation Date: **4/29/2009**

Sampler: **5.25-inch O.D. Sampler (20-Feet)**

Initial Groundwater Depth: **~24 ft. BLS**

Logged By: **Gerald Ingle**

Hole Diameter: **6.5 - inch**

Final Groundwater Depth: **23.42 ft. BTOC**

Description	USCS Class	Graphic Log	Depth	Sample Interval	Blows / 6"	
Dark red/purple, "fat" clay, some white and gray laminating, high plasticity, damp, no odor.	CH		20			
Tan/pink/orange, fine to medium SAND, wet, no odor.	SP		21			
			22			
			23			
			24			
Red/purple/orange, laminated CLAY, some sand seams up to 1/2-inch thick, medium plasticity, wet, no odor.	CL		25			
Dark red/purple, "fat" CLAY, trace very fine sand, high plasticity, wet, no odor.	CH		26			
			27			
Brown/tan, mottled, clayey very fine SAND, trace to some silt, wet, no odor.	SC		28			
			29			
Terminate Boring			30			
			31			
			32			
			33			
			34			
			35			
			36			
			37			
			38			
			39			
			40			

Notes:

1. USCS = Unified Soil Classification System.
2. Groundwater measured from top of casing.



Project: Timken US Corp.
 Location: Sylvania, Georgia
 SHA Project No.: 2151.01 T041

Log of Monitoring Well SH-101

Ground Elevation: 184.47 feet
 TOC Elevation: 184.56 feet
 PVC Elevation: 184.28 feet
 Datum: Mean Sea Level (MSL)

Drilling Method: Geoprobe® 6610DT w/ 4 1/4" I.D. HSA

Sampling Method: 5' MacroCore® Sampler

Groundwater Readings

Date	Time	Depth to Water	Ref. Pt.	Depth of Casing	Stab. Time
02/27/07	13:00	9.3'	Ground	20'	~1.5 hours
02/27/07	15:10	8.65'	Top of PVC	Well Installed	~2 hours
02/28/07	18:00	8.62'	Top of PVC	Well Installed	~1 day
03/03/07	09:02	8.44'	Top of PVC	Well Installed	~4 days

Drilling Company: Subsurface Environmental Investigations, LLC

Foreman: RJ Crater

Date Started: 02/27/07

Date Finished: 02/27/07

Logged By: M. Stein

Checked By: B. Green

BORING LOG: S:\CONDATA\2100\2152.01\TASK 041 - SYLVANIA, GALLOGS\215201T041 SYLVANIA LOGS.GPJ 2007 FEB SHA.GLB 2007 FEB SHA.GDT 4/19/07

Depth (ft)	Sample Information				Stratum		Geologic Description	Well Diagram	Well Description
	Sample No.	Depth (ft)	Pen/Rec (ft)	PID/FID Values (ppmv)	Log	Description			
0	S-1A	0 - 0.1	5/5	2	[Dashed pattern]	FILL	S-1A: TOPSOIL. Dry.	[Well diagram showing topsoil layer]	8" Dia. Flushmounted Road Box with Locking J Plug Set in Concrete Filter Sand (0.6 to 2')
	S-1B	0.1 - 5	---	ND			S-1B: Orangish tan, Clayey SILT, little fine to medium Sand grading to SILT and fine to medium Sand. Moist. FILL.		
2									
4									Bentonite Chip Seal (2 to 4')
6	S-2	5 - 10	5/4.5	ND			S-2: Orange, SILT, and fine to medium Sand grading to tan, fine to medium SAND, some Silt. Moist. FILL.		2" Dia. Sch. 40 PVC Riser (0.2 to 5.9')
8									
10	S-3	10 - 15	5/5	ND	[Dotted pattern]	SAND	S-3: Orangish tan to pink, fine to coarse SAND, little Silt. Moist to wet.	[Well diagram showing sand layer]	#2 Filter Sand (4 to 17.3') 2" Dia. Sch. 40 PVC Well Screen (0.010" Slots) (5.9 to 15.9')
12							S-4: Pink, fine to coarse SAND, some Silt. Wet.		
14									
16	S-4	15 - 20	5/5	13					2" Dia. Sch. 40 PVC Silt Cap (15.9 to 16.1')
18									
20							Boring terminated at 20 feet. No refusal encountered.		Formation Material (17.3 to 20')
22									
24									
26									
28									
30									

NOTES:

- Soil samples were screened for volatile organic compounds (VOCs) using a Photovac MicroFID flame ionization detector (FID) calibrated to a 100 parts per million by volume (ppmv) methane-in-air standard using a response factor of 1.0. Results are presented in ppm; the typical detection limit is 1 ppm. "ND" indicates not detected. The FID measures relative levels of VOCs. Although FID screening can not be used directly to quantify VOC concentrations or identify individual compounds, the results serve as a relative indicator for the presence of VOCs.
- No soil samples were submitted for laboratory analyses.



Project: Timken US Corp.
 Location: Sylvania, Georgia
 SHA Project No.: 2151.01 T041

Log of Monitoring Well SH-102

Ground Elevation: 186.91 feet
 TOC Elevation: 186.90 feet
 PVC Elevation: 186.60 feet
 Datum: Mean Sea Level (MSL)

Drilling Method: Geoprobe® 6610DT w/ 3/4" O.D. Casing

Sampling Method: 5' MacroCore® Sampler

Groundwater Readings

Date Time Depth to Water Ref. Pt. Depth of Casing Stab. Time

Drilling Company: Subsurface Environmental Investigations, LLC

Foreman: RJ Crater

Date Started: 02/28/07

Date Finished: 02/28/07

Logged By: M. Stein

Checked By: B. Green

BORING LOG S:\CONDATA\21002\152.01\TASK 041 - SYLVANIA, GA\LOGS\215201T041 SYLVANIA LOGS.GPJ 2007 FEB SHA.GLB 2007 FEB SHA.GDT 4/19/07

Depth (ft)	Sample Information				Stratum		Geologic Description	Well Diagram	Well Description
	Sample No.	Depth (ft)	Pen/Rec (ft)	PID/FID Values (ppmv)	Log	Description			
0	---	0 - 0.4	---	---	-----0'-----		0-0.4': Concrete slab.		6" Dia. Flushmounted Road Box with Locking J Plug Set in Concrete
0.4	S-1A	0.4 - 3.2	4.6/4.6	ND	-----0.4'-----		S-1A: Orangish brown to reddish brown, SILT & CLAY, little fine to medium Sand. Moist. FILL.		Filter Sand (0.6 to 2')
3.2	S-1B	3.2 - 5	---	ND			S-1B: Brown to orangish tan, fine SAND, little Silt. Moist. FILL.		2" Dia. Sch. 40 PVC Riser (0.3 to 6.7')
5	S-2	5 - 10	5/4.5	ND		FILL	S-2: Orangish brown to tan, fine SAND, little Silt. Moist. FILL.		Hydrated Granular Bentonite Seal (2 to 5')
10	S-3	10 - 15	5/4.4	ND	-----10'-----		S-3: Tan to orangish tan, Clayey SILT, some fine to medium Sand. Moist to wet.		#2 Filter Sand (5 to 17.5')
15	S-4A	15 - 15.9	5/5	ND		Clayey SILT	S-4A: Tan to orangish tan, Clayey SILT, some fine to medium Sand. Moist to wet.		2" Dia. Sch. 40 PVC Well Screen (0.010" Slots) (6.7 to 16.7')
15.9	S-4B	15.9 - 20	---	ND	-----15.9'-----		S-4B: Gray to purple, Silty CLAY. Mottled. Moist.		2" Dia. Sch. 40 PVC Silt Cap (16.7 to 16.9')
20					-----20'-----		Boring terminated at 20 feet. No refusal encountered.		Hydrated Granular Bentonite Seal (17.5 to 20')
<p>NOTES:</p> <ol style="list-style-type: none"> Soil samples were screened for volatile organic compounds (VOCs) using a Photovac MicroFID flame ionization detector (FID) calibrated to a 100 parts per million by volume (ppmv) methane-in-air standard using a response factor of 1.0. Results are presented in ppm; the typical detection limit is 1 ppm. "ND" indicates not detected. The FID measures relative levels of VOCs. Although FID screening can not be used directly to quantify VOC concentrations or identify individual compounds, the results serve as a relative indicator for the presence of VOCs. Soil sample S-1A (1-3.2' interval) was submitted for laboratory analyses. On 2/28/2007 at 1510 hours, on 3/1/2007 at 0755 hours, and on 3/3/2007 at 0942 hours, the monitoring well was dry. 									



Project: Timken US Corp.
 Location: Sylvania, Georgia
 SHA Project No.: 2151.01 T041

Log of Monitoring Well SH-103

Ground Elevation: 187.07 feet
 TOC Elevation: 187.07 feet
 PVC Elevation: 186.83 feet
 Datum: Mean Sea Level (MSL)

Drilling Method: Geoprobe® 6610DT w/ 3/4" O.D. Casing

Sampling Method: 5' MacroCore® Sampler

Groundwater Readings

Date	Time	Depth to Water	Ref. Pt.	Depth of Casing	Stab. Time
03/01/07	08:57	21.4'	Ground	25'	<15 minutes

Drilling Company: Subsurface Environmental Investigations, LLC

Foreman: RJ Crater

Date Started: 03/01/07

Date Finished: 03/01/07

Logged By: M. Stein

Checked By: B. Green

BORING LOG S:\CONDATA\1002\152.01\TASK 041 - SYLVANIA, GALLOGS\215201T041 SYLVANIA LOGS.GPJ 2007 FEB SHA.GLB 2007 FEB SHA.GDT 4/19/07

Depth (ft)	Sample Information				Stratum		Geologic Description	Well Diagram	Well Description
	Sample No.	Depth (ft)	Pen/Rec (ft)	PID/FID Values (ppmv)	Log	Description			
0	---	0 - 0.4	---	---	---	---	0-0.4': Concrete slab.	6" Dia. Flushmounted Road Box with Locking J Plug Set in Concrete	
0.4	S-1A	0.4 - 3.2	4.6/4.6	3	---	---	S-1A: Brown to reddish brown, SILT to Clayey SILT, and fine Sand. Moist. FILL.		
2						FILL		Filter Sand (0.3 to 2')	
4	S-1B	3.2 - 5	---	22			S-1B: Brown to light brown, fine SAND, little Silt. Moist. FILL.		
5	S-2	5 - 10	5/4.6	30			S-2: Orangish brown, Clayey SILT, some fine Sand. Moist.	Hydrated Granular Bentonite Seal (2 to 7')	
6						Clayey SILT		2" Dia. Sch. 40 PVC Riser (0.2 to 9.2')	
10	S-3	10 - 15	5/5	48			S-3: Orangish brown to orangish tan, fine to medium SAND and SILT. Moist.	9.2	
12						SAND & SILT		Filter Sand (7 to 19.2')	
15	S-4A	15 - 17.9	5/5	19			S-4A: Orangish brown to orangish tan, fine to medium SAND and SILT. Moist.	2" Dia. Sch. 40 PVC Well Screen (0.010" Slots) (9.2 to 19.2')	
18	S-4B	17.9 - 20	---	7			S-4B: Gray to purple to orange, Silty CLAY, trace fine Sand. Mottled. Moist.		
20	S-5	20 - 24	4/4	ND			S-5: Gray to purple to orange, Silty CLAY, little fine Sand. Mottled. Moist.	19.2	
20						Silty CLAY		2" Dia. Sch. 40 PVC Silt Cap (19.2 to 19.4')	
22								Bentonite Chip Seal (19.5 to 24')	
24							Boring terminated at 24 feet. No refusal encountered.		
<p>NOTES:</p> <ol style="list-style-type: none"> Soil samples were screened for volatile organic compounds (VOCs) using a Photovac MicroFID flame ionization detector (FID) calibrated to a 100 parts per million by volume (ppmv) methane-in-air standard using a response factor of 1.0. Results are presented in ppm; the typical detection limit is 1 ppm. "ND" indicates not detected. The FID measures relative levels of VOCs. Although FID screening can not be used directly to quantify VOC concentrations or identify individual compounds, the results serve as a relative indicator for the presence of VOCs. Soil sample S-3 (10-12' interval) was submitted for laboratory analyses. On 3/1/2007 at 1000 hours and on 3/3/2007 at 0955 hours, the monitoring well was dry. 									



Project: Timken US Corp.
 Location: Sylvania, Georgia
 SHA Project No.: 2151.01 T041

Log of Monitoring Well SH-104

Ground Elevation: 187.12 feet
 TOC Elevation: 187.12 feet
 PVC Elevation: 186.80 feet
 Datum: Mean Sea Level (MSL)

Drilling Method: Geoprobe® 6610DT w/ 3/4" O.D. Casing

Sampling Method: 5' MacroCore® Sampler

Groundwater Readings

Date Time Depth to Water Ref. Pt. Depth of Casing Stab. Time

Drilling Company: Subsurface Environmental Investigations, LLC

Foreman: RJ Crater

Date Started: 03/01/07

Date Finished: 03/01/07

Logged By: M. Stein

Checked By: B. Green

BORING LOG S:\CONDATA\1002152.01\TASK 041 - SYLVANIA, GALLOGS\215201T041 SYLVANIA LOGS.GPJ 2007 FEB SHA.GLB 2007 FEB SHA.GDT 4/19/07

Depth (ft)	Sample Information				Stratum		Geologic Description	Well Diagram	Well Description
	Sample No.	Depth (ft)	Pen/Rec (ft)	PID/FID Values (ppmv)	Log	Description			
0	---	0 - 0.4	---	---		0' - 0.4'	0-0.4': Concrete slab.		6" Dia. Flushmounted Road Box with Locking J Plug Set in Concrete
0.4	S-1A	0.4 - 1.2	4.6/3.3	ND			S-1A: Reddish brown, SILT & CLAY, little fine Sand. Moist. FILL.		Filter Sand (0.5 to 2')
1.2	S-1B	1.2 - 1.7	---	---			S-1B: Brown, fine SAND, little Silt. Moist. FILL.		
1.7	S-1C	1.7 - 5	---	2			S-1C: Reddish brown, SILT & CLAY, little fine Sand. Moist. FILL.		
5	S-2	5 - 10	5/5	1			S-2: Orangish brown to orangish tan, Clayey SILT, little fine to medium Sand. Moist. FILL.		Hydrated Granular Bentonite Seal (2 to 10')
10	S-3	10 - 15	5/3.8	1			S-3: Orangish tan to tan, Clayey SILT to SILT, and fine to medium Sand Moist. FILL.		2" Dia. Sch. 40 PVC Riser (0.3 to 11.9')
11.8									
15.6	S-4A	15 - 15.6	5/4.2	ND			S-4A: Orangish tan to tan, Clayey SILT to interlayered SILT and fine to medium Sand. Moist.		#2 Filter Sand (10 to 26.9')
15.6	S-4B	15.6 - 17.4	---	---			S-4B: Gray to tan, CLAY & SILT, little fine to medium Sand. Moist.		
17.4	S-4C	17.4 - 20	---	---			S-4C: Orangish tan, fine to medium SAND and SILT. Moist.		
20	S-5A	20 - 21	---	---			S-5A: Orangish tan, fine to medium SAND and SILT. Moist.		2" Dia. Sch. 40 PVC Well Screen (0.010" Slots) (11.9 to 26.9')
21	S-5B	21 - 23	---	---			S-5B: Purple to gray to orange, Silty CLAY, with partings of fine Sand. Moist.		
23	S-5C	23 - 24	---	---			S-5C: Orangish tan, fine SAND and SILT. Color and mineral stratifications. Moist.		
24	S-6A	24 - 25.5	---	---			S-6A: Light purple to orange, fine to medium SAND, little Silt. Moist to wet.		
25.5	S-6B	25.5 - 29	---	---			S-6B: Purple to gray, Silty CLAY and Clay, trace fine Sand. Moist.		2" Dia. Sch. 40 PVC Silt Cap (26.9 to 27.1')
27.1									Formation Material (27.1 to 27.5')
27.5									Bentonite Chip Seal (27.5 to 29')
29							Boring terminated at 29 feet. No refusal encountered.		
<p>NOTES:</p> <ol style="list-style-type: none"> Soil samples were screened for volatile organic compounds (VOCs) using a Photovac MicroFID flame ionization detector (FID) calibrated to a 100 parts per million by volume (ppmv) methane-in-air standard using a response factor of 1.0. Results are presented in ppm; the typical detection limit is 1 ppm. "ND" indicates not detected. The FID measures relative levels of VOCs. Although FID screening can not be used directly to quantify VOC concentrations or identify individual compounds, the results serve as a relative indicator for the presence of VOCs. Soil sample S-3 (13-15' interval) was submitted for laboratory analyses. On 3/1/2007 at 1215 hours and on 3/3/2007 at 1003 hours, the monitoring well was dry. 									



Project: Timken US Corp.
 Location: Sylvania, Georgia
 SHA Project No.: 2151.01 T041

Log of Monitoring Well SH-105

Ground Elevation: 187.09 feet
 TOC Elevation: 187.10 feet
 PVC Elevation: 186.81 feet
 Datum: Mean Sea Level (MSL)

Drilling Method: Geoprobe® 6610DT w/ 3/4" O.D. Casing

Sampling Method: 5' MacroCore® Sampler

Groundwater Readings

Date	Time	Depth to Water	Ref. Pt.	Depth of Casing	Stab. Time
03/01/07	16:00	29.4'	Ground	29.5'	<5 minutes

Drilling Company: Subsurface Environmental Investigations, LLC

Foreman: RJ Crater

Date Started: 03/01/07

Date Finished: 03/01/07

Logged By: M. Stein

Checked By: B. Green

Depth (ft)	Sample Information				Stratum		Geologic Description	Well Diagram	Well Description
	Sample No.	Depth (ft)	Pen/Rec (ft)	PID/FID Values (ppmv)	Log	Description			
0	---	0 - 0.5	---	---	---	---	0-0.5': Concrete slab.	6" Dia. Flushmounted Road Box with Locking J Plug Set in Concrete	Filter Sand (0.5 to 2')
0.5	S-1A	0.5 - 3.5	4.5/4.5	ND	---	S-1A: Orangish brown to reddish brown, SILT, and fine Sand grading to Clayey SILT, little fine Sand, trace Gravel. Moist. FILL.			
2						FILL			
4	S-1B	3.5 - 5	---	ND		S-1B: Brown, fine SAND, little Silt, grading to Clayey SILT, little fine Sand. Moist. FILL.			
5.2	S-2A	5 - 5.2	5/5	ND	---	S-2A: Light brown, Clayey SILT, little fine Sand. Moist. FILL.		Hydrated Granular Bentonite Seal (2 to 8')	2" Dia. Sch. 40 PVC Riser (0.3 to 10.2')
5.2	S-2B	5.2 - 10	---	ND	---	S-2B: Orangish brown to orangish tan, SILT and fine Sand. Moist.			
6						SILT			
10	S-3	10 - 15	5/5	ND	---	S-3: Orangish brown to orangish tan, SILT and fine Sand. grading to fine SAND, some Silt. Moist.			
12									
15	S-4	15 - 20	5/5	ND		S-4: Orangish tan, fine to medium SAND, some Silt. Moist.		Filter Sand (8 to 25.4')	2" Dia. Sch. 40 PVC Well Screen (0.010" Slots) (10.2 to 25.2')
20	S-5A	20 - 23.8	5/5	ND		S-5A: Orangish tan to tan, fine to medium SAND, some Silt. Moist to wet.			
23.8	S-5B	23.8 - 25	---	ND	---	S-5B: Purple to gray, Silty CLAY and Clay. Moist.			
25	S-6	25 - 29.5	4.5/4.5	ND		S-6: Purple to gray, Silty CLAY to CLAY. Few seams of saturated orangish tan, fine to medium Sand, little Silt. Moist.		2" Dia. Sch. 40 PVC Silt Cap (25.2 to 25.4')	Formation Material (25.4 to 26')
26						Silty CLAY to CLAY			
29.5							Boring terminated at 29.5 feet. No refusal encountered.		Bentonite Chip Seal (26 to 29.5')
30									
32	<p>NOTES:</p> <ol style="list-style-type: none"> Soil samples were screened for volatile organic compounds (VOCs) using a Photovac MicroFID flame ionization detector (FID) calibrated to a 100 parts per million by volume (ppmv) methane-in-air standard using a response factor of 1.0. Results are presented in ppm; the typical detection limit is 1 ppm. "ND" indicates not detected. The FID measures relative levels of VOCs. Although FID screening can not be used directly to quantify VOC concentrations or identify individual compounds, the results serve as a relative indicator for the presence of VOCs. Soil sample S-1A (0.5-3.5' interval) was submitted for laboratory analyses. On 3/3/2007 at 1010 hours, the monitoring well was dry. 								

BORING LOG S:\CONDATA\2100\2152.01\TASK 041 - SYLVANIA_GALOGS\215201T041 SYLVANIA_GALOGS.GPJ 2007 FEB SHA.GLB 2007 FEB SHA.GDT 4/19/07



Project: Timken US Corp.
 Location: Sylvania, Georgia
 SHA Project No.: 2151.01 T041

Log of Monitoring Well SH-106

Ground Elevation: 187.05 feet
 TOC Elevation: 187.05 feet
 PVC Elevation: 186.78 feet
 Datum: Mean Sea Level (MSL)

Drilling Method: Geoprobe® 6610DT w/ 3/4" O.D. Casing

Sampling Method: 5' MacroCore® Sampler

Groundwater Readings

Date Time Depth to Water Ref. Pt. Depth of Casing Stab. Time

Drilling Company: Subsurface Environmental Investigations, LLC

Foreman: RJ Crater

Date Started: 03/02/07

Date Finished: 03/02/07

Logged By: M. Stein

Checked By: B. Green

BORING LOG S:\CONDATA\21002152.01\TASK 041 - SYLVANIA, GALLOGS\215201T041 SYLVANIA LOGS.GPJ 2007 FEB SHA.GLB 2007 FEB SHA.GDT 4/19/07

Depth (ft)	Sample Information				Stratum		Geologic Description	Well Diagram	Well Description
	Sample No.	Depth (ft)	Pen/Rec (ft)	PID/FID Values (ppmv)	Log	Description			
0	---	0 - 0.5	---	---		-----0'-----	0-0.5': Concrete slab.		6" Dia. Flushmounted Road Box with Locking J Plug Set in Concrete
0.5	S-1	0.5 - 5	4.5/4	76		-----0.5'-----	S-1: Reddish brown to light brown, SILT & CLAY to Clayey SILT, little fine Sand. Layers approximately 0.3 to 0.4' thick of brown, fine Sand, little Silt.. Moist. FILL.		Filter Sand (0.5 to 2')
2									
4									
5	S-2	5 - 10	5/4.5	139			S-2: Light brown, Clayey SILT, grading to orangish tan to tan, fine SAND, some Silt, trace Gravel. Moist. FILL.		Hydrated Granular Bentonite Seal (2 to 7.5')
6									2" Dia. Sch. 40 PVC Riser (0.3 to 9.4')
8									
10	S-3A	10 - 11.2	5/3.9	20			S-3A: Light brown, Clayey SILT, grading to orangish tan to tan, fine SAND, some Silt, trace Gravel. Moist. FILL.		
11.2	S-3B	11.2 - 15	---	82		-----11.2'-----	S-3B: Pink to orangish tan to tan, Clayey SILT, some fine to medium Sand. Moist.		Filter Sand (7.5 to 20')
12									2" Dia. Sch. 40 PVC Well Screen (0.010" Slots) (9.4 to 19.4')
14									
15	S-4A	15 - 18.4	5/5	112			S-4A: Tan, Clayey SILT to SILT, and fine to medium Sand. Moist to wet.		
16									
18	S-4B	18.4 - 20	---	28		-----18.4'-----	S-4B: Purple to gray, Silty CLAY. Mottled. Moist.		
20	S-5	20 - 25	5/5	29			S-5: Tan, Silty CLAY. Mottled. Moist.		2" Dia. Sch. 40 PVC Silt Cap (19.4 to 19.6')
22									Bentonite Chip Seal (20 to 25')
24									
25						-----25'-----	Boring terminated at 25 feet. No refusal encountered.		
26									
28							NOTES: 1. Soil samples were screened for volatile organic compounds (VOCs) using a Photovac MicroFID flame ionization detector (FID) calibrated to a 100 parts per million by volume (ppmv) methane-in-air standard using a response factor of 1.0. Results are presented in ppm; the typical detection limit is 1 ppm. "ND" indicates not detected. The FID measures relative levels of VOCs. Although FID screening can not be used directly to quantify VOC concentrations or identify individual compounds, the results serve as a relative indicator for the presence of VOCs. 2. Soil samples S-2 (5-10' interval) and S-3B (11.2-15' interval) were submitted for laboratory analyses. 3. All SH-106 soils had a low to moderate solvent- and/or petroleum-like odor. 4. On 3/2/2007 at 1015 hours and 3/3/2007 at 1029 hours, the monitoring well was dry.		
30									
32									
34									



Project: Timken US Corp.
 Location: Sylvania, Georgia
 SHA Project No.: 2151.01 T041

Log of Monitoring Well SH-107

Ground Elevation: 187.03 feet
 TOC Elevation: 187.03 feet
 PVC Elevation: 186.76 feet
 Datum: Mean Sea Level (MSL)

Drilling Method: Geoprobe® 6610DT w/ 3/4" O.D. Casing

Sampling Method: 5' MacroCore® Sampler

Groundwater Readings

Date	Time	Depth to Water	Ref. Pt.	Depth of Casing	Stab. Time
03/03/07	10:25	21.73'	Top of PVC	Well Installed	~1 day

Drilling Company: Subsurface Environmental Investigations, LLC

Foreman: RJ Crater

Date Started: 03/02/07

Date Finished: 03/02/07

Logged By: M. Stein

Checked By: B. Green

BORING LOG S:\CONDATA\21002152.01\TASK 041 - SYLVANIA, GALLOGS\215201T041 SYLVANIA LOGS.GPJ 2007 FEB SHA.GLB 2007 FEB SHA.GDT 4/19/07

Depth (ft)	Sample Information				Stratum		Geologic Description	Well Diagram	Well Description
	Sample No.	Depth (ft)	Pen/Rec (ft)	PID/FID Values (ppmv)	Log	Description			
0	---	0 - 0.6	---	---		-----0'-----	0-0.6': Concrete slab.		6" Dia. Flushmounted Road Box with Locking J Plug Set in Concrete
0.6	S-1A	0.6 - 2.9	4.4/3.8	ND		-----0.6'-----	S-1A: Reddish brown, SILT & CLAY, little fine to medium Sand. Moist. FILL.		Filter Sand (0.3 to 2')
2.9	S-1B	2.9 - 5	---	ND			S-1B: Brown to light brown, fine SAND, little Silt, grading to SILT and fine Sand. Moist. FILL.		
5	S-2	5 - 10	5/4.2	ND		-----5'-----	S-2: Light brown to orangish tan to tan, SILT and fine Sand. Moist.		
10	S-3A	10 - 11.6	5/4.5	ND			S-3A: Light brown to orangish tan to tan, SILT and fine Sand. Moist.		Hydrated Granular Bentonite Seal (2 to 10')
11.6	S-3B	11.6 - 15	---	ND		-----11.6'-----	S-3B: Tan, Clayey SILT to SILT, and fine to medium Sand. Moist.		2" Dia. Sch. 40 PVC Riser (0.3 to 12.1')
15	S-4	15 - 20	5/5	ND		-----15'-----	S-4: Reddish brown to tan to brown, fine to medium SAND and SILT. Moist to wet.		Filter Sand (10 to 22.5')
20	S-5A	20 - 21	5/4.8	ND		-----20'-----	S-5A: Tan to brown, Clayey SILT, some fine to medium Sand. Moist to wet.		2" Dia. Sch. 40 PVC Well Screen (0.010" Slots) (12.1 to 22.1')
21	S-5B	21 - 25	---	ND		-----21'-----	S-5B: Purple to gray to orange, Silty CLAY, trace fine Sand. Mottled. Moist.		2" Dia. Sch 40 PVC Silt Cap (22.1 to 22.3')
25						-----25'-----	Boring terminated at 25 feet. No refusal encountered.		Formation Material (22.4 to 25')

NOTES:

- Soil samples were screened for volatile organic compounds (VOCs) using a Photovac MicroFID flame ionization detector (FID) calibrated to a 100 parts per million by volume (ppmv) methane-in-air standard using a response factor of 1.0. Results are presented in ppm; the typical detection limit is 1 ppm. "ND" indicates not detected. The FID measures relative levels of VOCs. Although FID screening can not be used directly to quantify VOC concentrations or identify individual compounds, the results serve as a relative indicator for the presence of VOCs.
- Soil sample S-1B (2.9-5' interval) was submitted for laboratory analyses.
- On 3/2/2007 at 1130 hours, the monitoring well was dry.

Pilot Test Boring PTB-01

Project: <i>IR-Sylvania</i>	Drill Rig: <i>Geoprobe 6610DT</i>	Top of Casing Elevation: 186.80 ft. AMSL
Installation Date: <i>December 21, 2009</i>	Sampler: <i>N/A</i>	Initial Groundwater Depth: <i>N/A</i>
Logged By: <i>Gerald Ingle</i>	Hole Diameter: 2.5 - inch	Final Groundwater Depth: 16.01 ft. BTOC

Description	USCS Class	Graphic Log	Depth	Sample Interval	Blows / 6"	Diagram
Refer to Lithology for MW-C1			0 1 2 3 4 5 6 7 8 9 10 11 12 13 14 15 16 17 18 19 20			

<p style="font-size: small;">2580 Northeast Expressway • Atlanta Georgia 30345 Telephone: (404) 329-9006 • Fax: (404) 329-2057</p>	<p>Notes:</p> <ol style="list-style-type: none"> 1. USCS = Unified Soil Classification System. 2. Groundwater measured from top of casing. 	<p>Project No. 1162-1001-5</p> <p>Page 1 of 1</p>
File name: G:\DWG\1162-1101 Sylvania\05\Well Logs		Print Date: 2011-10-19

Pilot Test Boring PTB-02

Project: <i>IR-Sylvania</i>	Drill Rig: <i>Geoprobe 6610DT</i>	Top of Casing Elevation: 186.80 ft. AMSL
Installation Date: December 21, 2009	Sampler: <i>N/A</i>	Initial Groundwater Depth: <i>N/A</i>
Logged By: Gerald Ingle	Hole Diameter: 2.5 - inch	Final Groundwater Depth: 16.11 ft. BTOC

Description	USCS Class	Graphic Log	Depth	Sample Interval	Blows / 6"	Diagram
Refer to Lithology for MW-C1			0 1 2 3 4 5 6 7 8 9 10 11 12 13 14 15 16 17 18 19 20			

<p>Atlanta Environmental Management, Inc. <i>Environmental Consulting, Engineering, Hydrogeologic Services</i></p> <p>2580 Northeast Expressway • Atlanta Georgia 30345 Telephone: (404) 329-9006 • Fax: (404) 329-2057</p>	<p>Notes:</p> <ol style="list-style-type: none"> 1. USCS = Unified Soil Classification System. 2. Groundwater measured from top of casing. 	<p>Project No. 1162-1001-5</p> <p>Page 1 of 1</p>
File name: G:\DWG\1162-1101 Sylvania\05\Well Logs		Print Date: 2011-10-19

Pilot Test Boring PTB-04

Project: <i>IR-Sylvania</i>	Drill Rig: <i>Geoprobe 6610DT</i>	Top of Casing Elevation: 186.89 ft. AMSL
Installation Date: <i>December 21, 2009</i>	Sampler: <i>N/A</i>	Initial Groundwater Depth: <i>N/A</i>
Logged By: <i>Gerald Ingle</i>	Hole Diameter: 2.5 - inch	Final Groundwater Depth: 15.92 ft. BTOC

Description	USCS Class	Graphic Log	Depth	Sample Interval	Blows / 6"	Diagram
Refer to Lithology for MW-C1			0 1 2 3 4 5 6 7 8 9 10 11 12 13 14 15 16 17 18 19 20			

	Notes: 1. USCS = Unified Soil Classification System. 2. Groundwater measured from top of casing.	Project No. 1162-1001-5 Page 1 of 1
File name: G:\DWG\1162-1101 Sylvania\05Well Logs		Print Date: 2011-10-19